CERTIFIED LAND CORNER RESTORATION

Index No. R-9

State of Wisconsin } ss.
County of Oneida

I Philip T. Hansen, do hereby certify that on the 18th day of May, 1977, I found evidence of the Section corner of Sec. 20, 21, 28, 29 Township 38, North, Range 10 East, Fourth Principal Meridian, as described hereon; and that from this evidence I established a new monument and accessories as described hereon to perpetuate the original location of this corner.

Resident witnesses:

Jim Claflin

Herb Wagoner

WISCONSIN PHILIP T. HANSEN ARBORNE, WIS. S-498 LAND SURVEYOR

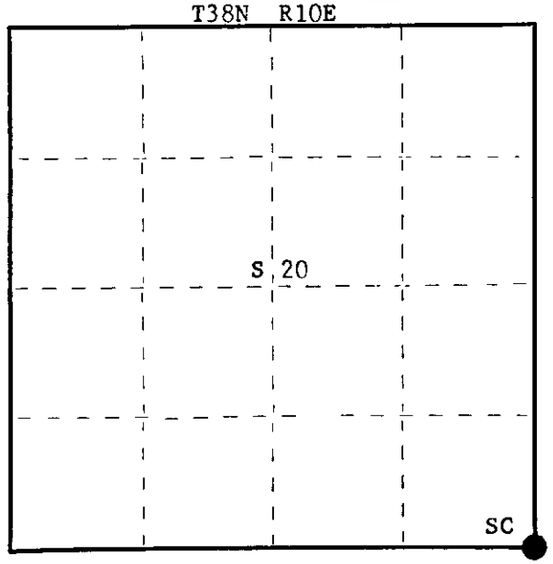

○ = Corner monument restored.

History of original corner establishment:

Corner established by Wm. E. Dougherty, Deputy Surveyor, in 1863, from which Hemlock 8" bears S46°W, 5 links; White Pine 10" bears N61°E, 31 links.
Corner restored by B.F. Dorr, County Surveyor. Recovered original BTs.
Corner recovered and restored by N. Loftus, Ripco Surveyor. Set new 2" iron pipe.

Description of corner evidence found:

Recovered 2" iron pipe with 4" square brass cap, stamped:
Monument projects 26" above ground.
Recovered OBTs - Aspen stump 8" S72°W, 29.8 links.
Aspen stump 6" S70°W, 9.7 links.

T38N R10E
20 21
29 28
RIPCO

Description of monument and accessories I established to perpetuate the original location of this corner.

Marked NBTs - White Birch 6" S78°W, 38.1 links - scribed SC BT.
White Birch 8" N38°E, 89.4 links - scribed SC BT.

Dated at Rhinelander, Wis., this 8th day of June, 1977.

Signature Philip T. Hansen Title Registered Land Surveyor Registration No. S-498
(County Surveyor, Registered Land Surveyor, or other duly authorized official)

Office of Register of Deeds, County of Oneida, I hereby certify that the within instrument was filed in this office for record on the 23rd day of June, 1977 at 12:40 o'clock P. M.

Doris Verage Kuehn
(Register of Deeds)

By ..... Deputy

FORM 985

38102000