

CERTIFIED LAND CORNER RESTORATION



Index No. **0-8**

State of Wisconsin

County of Oneida } ss.

I Phillip T. Hansen do hereby certify that on the 20th day of May 19 77, I found evidence of the NE 1/16 corner of the Section 20 Township 38, North, Range 10 East, Fourth Principal Meridian, as described hereon; and that from this evidence I established a new monument and accessories as described hereon to perpetuate the original location of this corner.

Resident witnesses:
Jim Clafin
Herb Wagoner

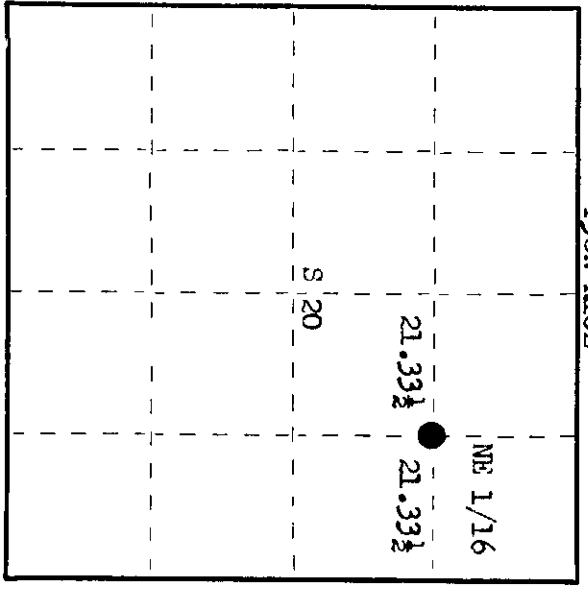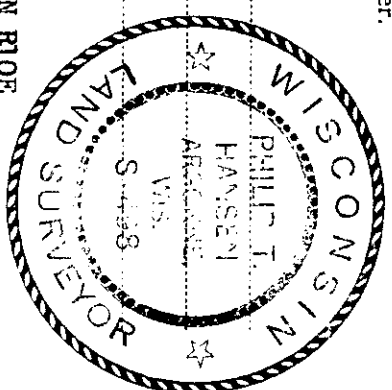

○ = Corner monument restored.

History of original corner establishment:

Corner established by N. Loftus, Ripco Surveyor, in 1954. Ran a random line west from a point 33 links south of N 1/16 on E line, bearing N89°W, a distance of 82.76 chains, fell 66 links north of N 1/16 on west line. Blazed true line and set NE 1/16 at 21.33 1/2 chains and NW 1/16 at 42.67 chains.

Description of corner evidence found:

Recovered 1" iron pipe with a 2" square brass cap in good condition and firmly in ground.
Recovered OBT - Balsam 6" S51°E, 31.0 links, scribing not legible.
Maple 5" N11°W, 43.6 links, scribing legible.

Cap stamped:

There is also another iron pipe beside monument 24" above ground.
T38N R10E
NE 1/16 S20
RIPCO

Description of monument and accessories I established to perpetuate the original location of this corner.
As monument was recovered in good condition, it was left as found.
Monument projects 24" above ground.
NBT - Sugar 6" S8°W, 32.4 links, scribed 1/16 BT.

Dated at Rhinelander, Wis., this 26th day of May, 19 77.

Signature Phillip T. Hansen Title Registered Land Surveyor Registration No. S-498
(County Surveyor, Registered Land Surveyor, or other duly authorized official)
Office of Register of Deeds, County of Oneida
at 10:30 o'clock AM day of May, 19 77.
I hereby certify that the within instrument was filed in this office for record on the 26th day of May, 19 77.

George George Kuehn
(Register of Deeds)

By..... Deputy