

CERTIFIED LAND CORNER RESTORATION

Index No. **0-6**



State of Wisconsin } ss.
County of Oneida

I Phillip T. Hansen, do hereby
certify that on the 20th day
of May, 1977, I found
evidence of the NW 1/16
corner of Section 20
Township 38, North, Range
10 East, Fourth Principal Meridian,
as described hereon; and that from this evidence
I established a new monument and accessories
as described hereon to perpetuate the original
location of this corner.

Resident witnesses:

Jim Clarfin

Herb Wagoner

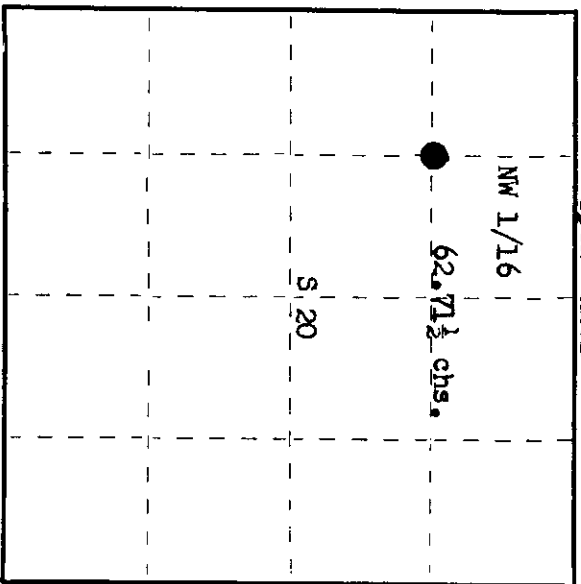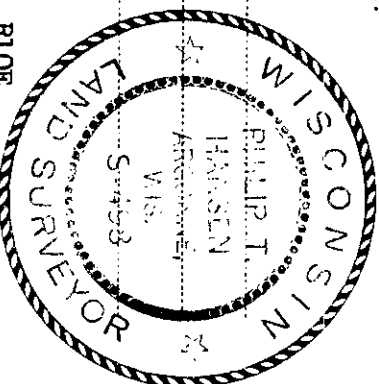

○ = Corner monument restored.

History of original corner establishment:

Corner established by N. Loftus, Ripco Surveyor, in 1954. Ran random line west from a point 33 links south of N 1/16 on east line, bearing N89°W a distance of 82.76 chains, fell 66 links north of North 1/16 on west line. Blazed true line and set NW 1/16 at 62.71 1/2 chains. Could not find any corners on line, but did find old blazes along true line.

Description of corner evidence found:

Recovered 1" OD iron pipe with 2" square brass cap in good condition and securely in ground.
Also recovered a 2" iron pipe next to the corner. Cap stamped:
Recovered OBT - Maple 6" S8°W, 4.2 links, scribed BT.

T38N R10E
NW 1/16 S20
RIPCO

Description of monument and accessories I established to perpetuate the original location of this corner.
As monument was recovered in good condition, it was left as found.

Monument projects 24" above ground.
MBT - Maple 6" N61°W, 103.3 links, scribed 1/16 BT.

Dated at Rhinelander, Wis., this 26th day of May, 1977

Signature Phillip T. Hansen Title Registered Land Surveyor Registration No. S-498
(County Surveyor, Registered Land Surveyor, or other duly authorized official)
Office of Register of Deeds, County of Oneida
Instrument was filed in this office for record on the 27th day of June, 1977
at 10:30 o'clock AM.

Signature Doris L. George
(Register of Deeds)

By: _____ Deputy

3302020187