

CERTIFIED LAND CORNER RESTORATION



Index No. **R-11**

State of Wisconsin


I, Philip T. Hansen, do hereby certify that on the 15th day of October, 1977, I found evidence of the 7/4 corner of Section 31 Township 32, North, Range 12 East, Fourth Principal Meridian, as described hereon; and that from this evidence I established a new monument and accessories as described hereon to perpetuate the original location of this corner.

Resident witnesses:
Philip T. Hansen
Arnonne
MIS

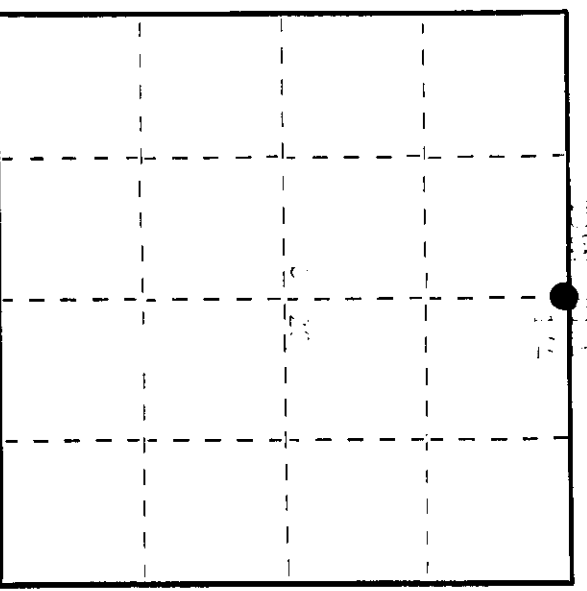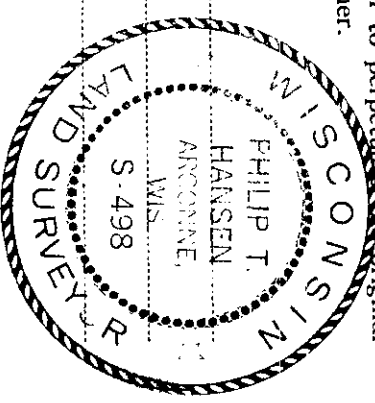

○ = Corner monument restored.

History of original corner establishment:


Description of corner evidence found:


Description of monument and accessories I established to perpetuate the original location of this corner:


Dated at Clark, Wis., this 15th day of October, 1977

Signature Philip T. Hansen Title Registered Land Surveyor Registration No. 498
(County Surveyor, Registered Land Surveyor, or other duly authorized official)

Office of Register of Deeds, County of Clark, Wis.
Instrument was filed in this office for record on the 15th day of October, 1977
at 1:30 o'clock P. M.

Doris George Kuehn
(Register of Deeds)

By Joseph M. Boernel Deputy

3810210020