FORM 983 H. C. MILLER CO., MILWAUKEE

CERTIFIED LAND CORNER RESTORATION

Index No. *R-24*

State of Wisconsin
County of Oneida [illegible] } ss.

I [illegible] do hereby certify that on the [illegible] day of [illegible], 1977, I found evidence of the [illegible] corner of [illegible] Township [illegible], North, Range [illegible] East, Fourth Principal Meridian, as described hereon; and that from this evidence I established a new monument and accessories as described hereon to perpetuate the original location of this corner.

Resident witnesses:

[illegible]

[illegible]

WISCONSIN PHILIP T. HANSEN [illegible] S-498 LAND SURVEYOR

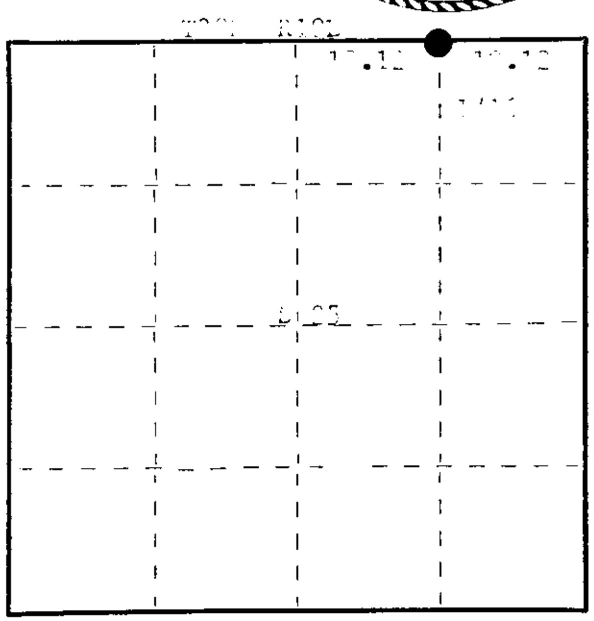

○ = Corner monument restored.

History of original corner establishment:

Corner established by [illegible] and [illegible], [illegible] surveyors, in 1866. [illegible] line from [illegible] chains to [illegible] north of [illegible] 1/4 corner. Corrected [illegible]. Set [illegible] 10.12 chains [illegible] corrected line.

[illegible] – [illegible], [illegible] links
[illegible], [illegible] links

Description of corner evidence found:

Recovered [illegible] square brass [illegible]
[illegible]
[illegible]
[illegible]

Description of monument and accessories I established to perpetuate the original location of this corner.

[illegible]
[illegible]

Dated at [illegible], Wis., this 15th day of December, 1977.

Signature *Philip T. Hansen* Title [illegible] Registration No. [illegible]
(County Surveyor, Registered Land Surveyor, or other duly authorized official)

Office of Register of Deeds, County of Oneida, I hereby certify that the within instrument was filed in this office for record on the *22nd* day of *December*, 1977 at *2:02* o'clock *P*. M.

Doris Veraga Kuehn
(Register of Deeds)

By *Joseph M. Boomer* Deputy

3810-7400