

CERTIFIED LAND CORNER RESTORATION



Index No. **Y-25**

State of Wisconsin




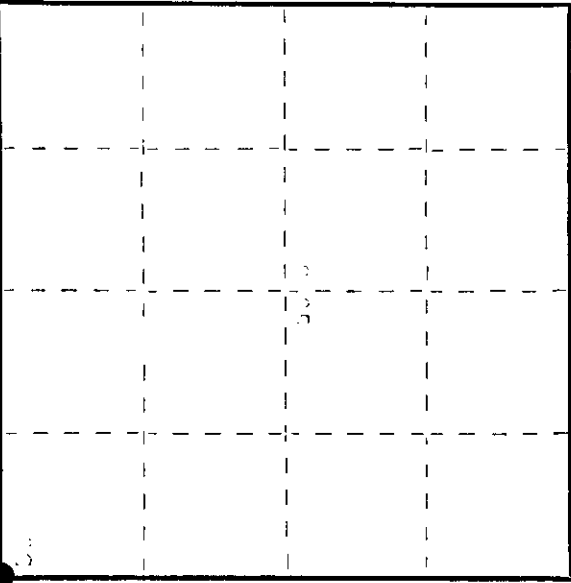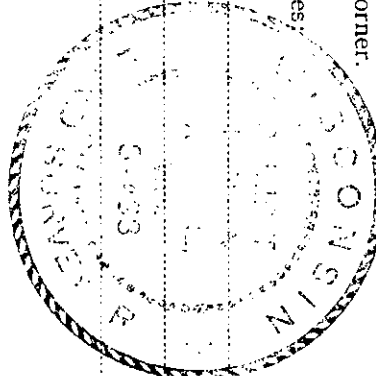













3810250000