

CERTIFIED LAND CORNER RESTORATION



Index No. U-23

State of Wisconsin


I, Philip D. Starnum, do hereby certify that on the 1st day of March, 1977, I found evidence of the SE corner of Section 16 of Township 26, North, Range 10, East, Fourth Principal Meridian, as described hereon; and that from this evidence I established a new monument and accessories as described hereon to perpetuate the original location of this corner.

Resident witnesses:

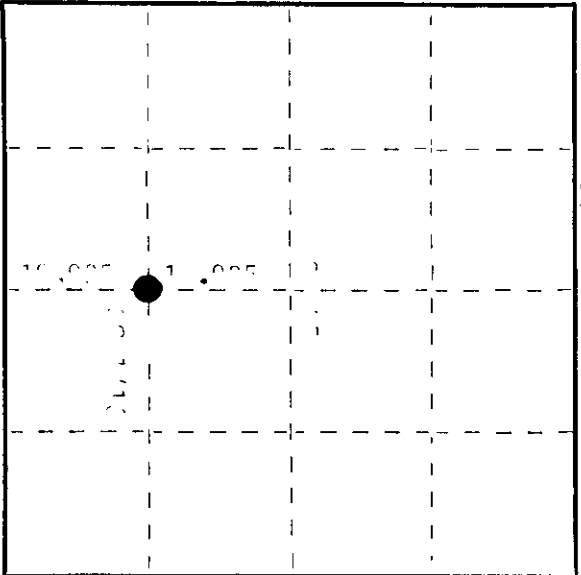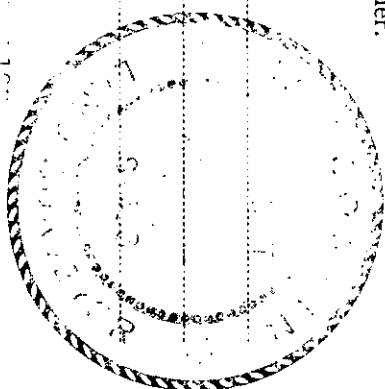

○ = Corner monument restored.

History of original corner establishment:


Description of corner evidence found:

*[Faint, illegible text describing the corner evidence found.]*

Description of monument and accessories I established to perpetuate the original location of this corner.



(County Surveyor, Registered Land Surveyor, or other duly authorized official)

Instrument was filed in this office for record on the 3rd day of January, 1978  
at 3:00 o'clock P. M.

Gene Leeger  
(Register of Deeds)

By Georg M. Bremer Deputy