

CERTIFIED LAND CORNER RESTORATION



Index No. **7-23**

State of Wisconsin



Resident witnesses:

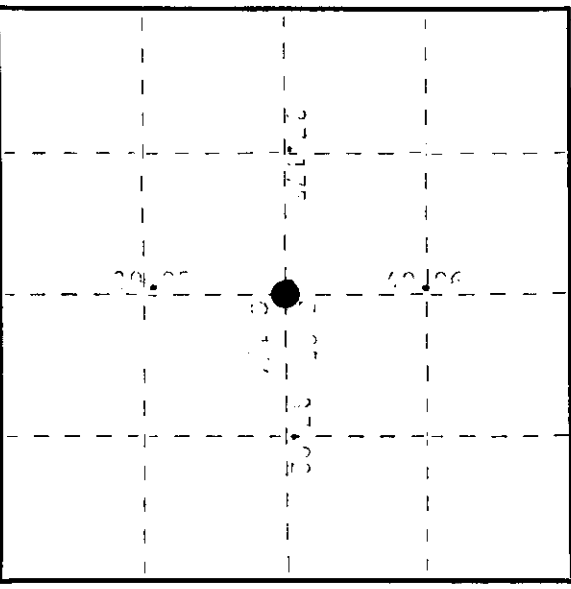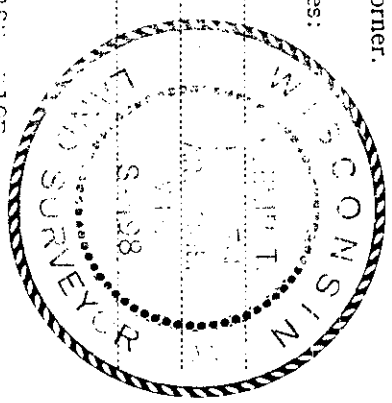

O = Corner monument restored.

History of original corner establishment:


Description of corner evidence found:


Description of monument and accessories I established to perpetuate the original location of this corner.






