

CERTIFIED LAND CORNER RESTORATION

Index No. U-21

State of Wisconsin





as described hereon; and that from this evidence I established a new monument and accessories as described hereon to perpetuate the original location of this corner.

Resident witnesses:

St. Charles

North, Range

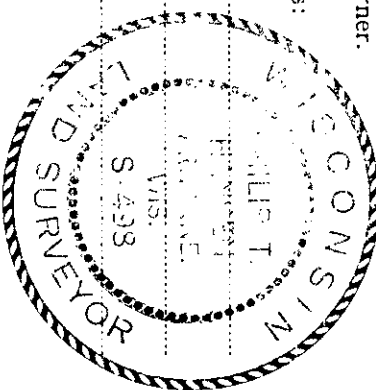

| | | | | | |
|--|--|--|--|--|--|
| | | | | | |
| | | | | | |
| | | | | | |
| | | | | | |
| | | | | | |
| | | | | | |

○ = Corner monument restored.

History of original corner establishment:


Description of corner evidence found:







 (County Surveyor, Registered Land Surveyor, or other duly authorized official)



