

CERTIFIED LAND CORNER RESTORATION

Index No. T-21

State of Wisconsin


County of Oneida } ss.

I Philip T. Hansen, do hereby certify that on the 8th day of December, 1977, I found evidence of the Quarter corner of Section 25 & 26 Township 38, North, Range 10 East, Fourth Principal Meridian, as described hereon; and that from this evidence I established a new monument and accessories as described hereon to perpetuate the original location of this corner.


Resident witnesses:

Jim Claflin

Herb Wagoner

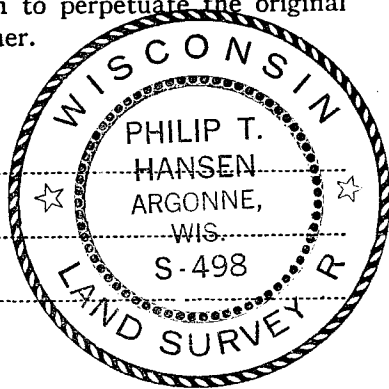

FORM 985 H. C. MILLER CO., MILWAUKEE

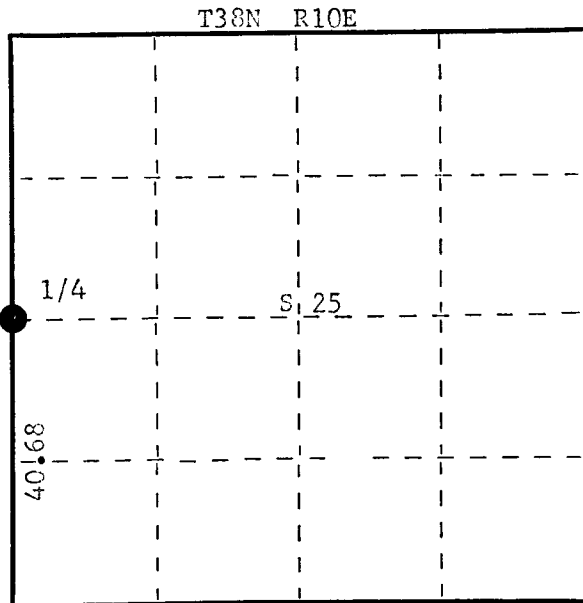

○ = Corner monument restored.

History of original corner establishment:

Original Corner established by Wm. E. Dougherty, Deputy Surveyor, in 1863 from which Hemlock 20" bears S46°W, 25 links and Birch 15" bears N25°E, 45 links.

Goddard and crew, Ripco surveyors, recovered a corner here in 1960. Ran random line south, bearing 179° 35' mag. to the SW Section Corner, distance of 40.68 chains. No reference to any BTs established.

Description of corner evidence found:

Recovered 3/4" iron pipe without brass cap. Retraced their calls for survey of line and found iron pipe to be in correct position. No evidence of any BTs recovered.

Description of monument and accessories I established to perpetuate the original location of this corner.

Replaced 3/4" iron pipe with 2" iron pipe with brass cap. Stamped: Monument projects 18" above ground. Marked NBTs - Jack Pine 7" S22°E, 95.0 links
Jack Pine 7" S40°E, 85.0 links
Jack Pine 6" S77°E, 113.9 links, all scribed 1/4 BT.

S498
T38N R10E
1/4 S26 | S25
CFI-1977

Dated at Rhineland, Wis., this 15th day of December, 1977

Signature Philip T. Hansen Title Registered Land Surveyor Registration No. S-498
(County Surveyor, Registered Land Surveyor, or other duly authorized official)

Office of Register of Deeds, County of Oneida, I hereby certify that the within instrument was filed in this office for record on the 22nd day of December, 1977 at 2⁰⁰ o'clock P M.

Doris Verage Kuehn
(Register of Deeds)

By Joseph M. Boomer Deputy

0002262000