U.S. PUBLIC LAND SURVEY MONUMENT RECORD

Note: This form is intended and designed to fulfill all requirements of Wisconsin Administrative Code, Chapter A-E 7.08 U.S Public Land Survey Monument Record (3) (a) (b) (c) (d) (e) (f) (g) (h) (i). An additional sheet may be added if necessary t conform with said requirements.

(a) Corner location: Township 38 North

Range 10 East/West

Town/City/Village Three Lakes

County Oneida

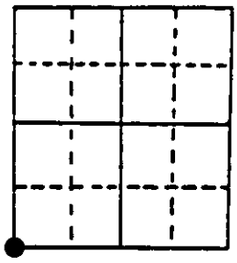

Section 26

(b) (f) (g) (h) Description of monument found at this corner and if it was accepted, state all evidence (material, testimonial, occupational, plats, records, other monuments) used as a basis for accepting. If not accepted or if nothing was found, state evidence used as basis for establishing location. If reestablished through lost corner proportionate methods, indicate all monuments, distances and directions used to establish. Indicate type of monument found or set and sign post.

1863 - Daugherty North between Sections 34 & 35 80.00 ch. set post.
Original B.T.'s Hemlock 8" S32°W 22 lks.
Hemlock 30" N36°E 7 lks.

1958 - Loftus (RIPCO) set monument at corner.

2002 - Recovered 2" dia. iron pipe - brass cap monument and Cedar B.T.
Made new B.T.'s and and set plastic sign post.

(c) (d) (e) Plan view of corner with ties to at least 4 witness monuments. If in disagreement with previously established corner, show the distances between the two corners and also indicate the ties to the disputed corner.

N Mag

Note: All measurements made to nail in side of tree.

Plastic sign post bears East 0.75'.

Scale: 1" = 20'

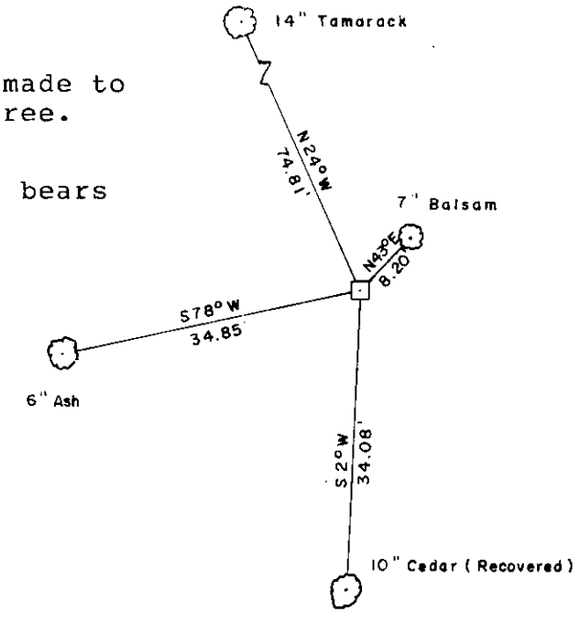

⊡ Ripco iron pipe - brass plate monument found.

(i) I, Kip W. Soder R.L.S #1731 (type or print name) certify that the corner location on this record was determined by me or under my direction and control and that this U.S. Public Land Survey Monument Record is correct and complete to the best of my knowledge and belief.

Kip W. Soder 2/26/2002

Signature Date

WISCONSIN KIP W. SODER S-1731 THREE LAKES, WI LAND SURVEYOR

3810270000

Stamp

Index No. V-17