CERTIFIED LAND CORNER RESTORATION

Index No. U-15

38/037/020

State of Wisconsin
County of Oneida } ss.

I Philip T. Hansen, do hereby certify that on the 12th day of October, 19 77, I found evidence of the SC 1/16 corner of Sec. 27 Township 38, North, Range 10 East, Fourth Principal Meridian, as described hereon; and that from this evidence I established a new monument and accessories as described hereon to perpetuate the original location of this corner.

Resident witnesses:

[illegible]

[illegible]

WISCONSIN PHILIP T. HANSEN WIS. S 498 LAND SURVEYOR

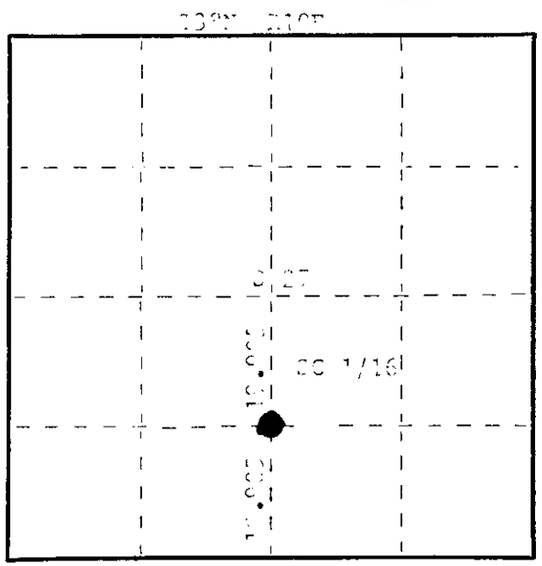

○ = Corner monument restored.

History of original corner establishment:

Corner established by N. Lofts, Fed. surveyor, in 1859.
Ran N-S and E-W 1/4 lines from previously recovered or established 1/4 corners.
Established SC corner at 39.81 chains N of 1/4 E of SC corner. Set SC 1/16 at 19.905 chains intermediate.
Marked WBTs - Sugar Maple 7" 225°, 23½ links
Sugar Maple 7" N26°, 9 links

Description of corner evidence found:

Recovered 3/4" x [illegible] iron pipe with 2" square brass cap in good condition.
Remainder of post 20" above ground. Set stone at:
Set WBTs - Sugar 7" (10") N20°, 8.0 links, [illegible]
Sugar 7" (9") S15°, 22.25 links, [illegible]

S 1/4 C 1/4 27

Description of monument and accessories I established to perpetuate the original location of this corner.

No additional accessories established.

Dated at Rhinelander, Wis., this 2nd day of November, 19 77

Signature Philip T. Hansen Title Registered Land Surveyor Registration No. [illegible]
(County Surveyor, Registered Land Surveyor, or other duly authorized official)

Office of Register of Deeds, County of Oneida, I hereby certify that the within instrument was filed in this office for record on the 12th day of December, 1977 at 11:00 o'clock A. M.

Doris Veraye Kuehn
(Register of Deeds)

By Joseph M. Boomer Deputy

FORM 985 M. C. MILLER CO., MILWAUKEE