

CERTIFIED LAND CORNER RESTORATION



Index No. U-14

State of Wisconsin


I, James P. ..., do hereby certify that on the 11th day of October, 1977, I found evidence of the original corner of Section 16, Township 3rd, North, Range 10th, East, Fourth Principal Meridian, as described hereon; and that from this evidence I established a new monument and accessories as described hereon to perpetuate the original location of this corner.

Resident witnesses:

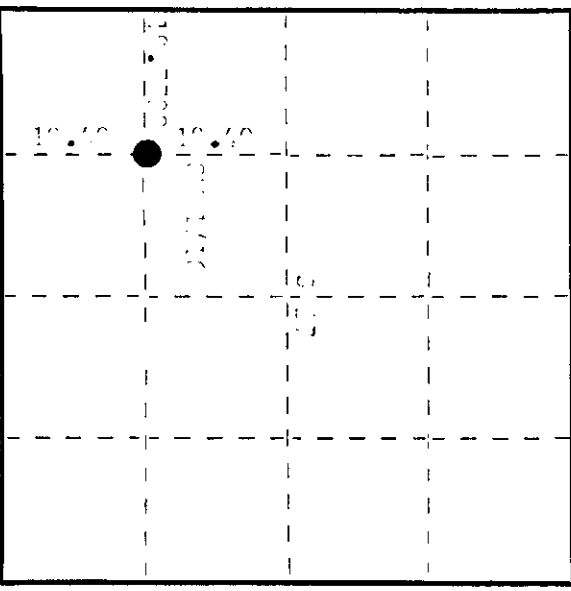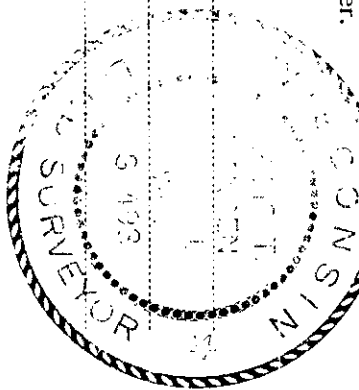

○ = Corner monument restored.

History of original corner establishment:

Corner established by ... in 1970. ...

Description of corner evidence found:


Description of monument and accessories I established to perpetuate the original location of this corner.



Dated at ..., Wis., this 11th day of October, 1977.

Signature James P. ... Title ... Registration No. ...
(County Surveyor, Registered Land Surveyor, or other duly authorized official)


Doris George Tuck
(Register of Deeds)

By Joseph M. Boerner Deputy

3810291030