

State of Wisconsin





Resident witnesses:



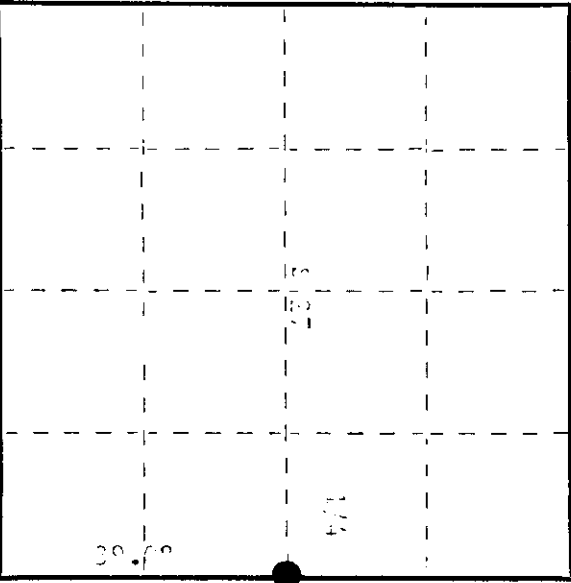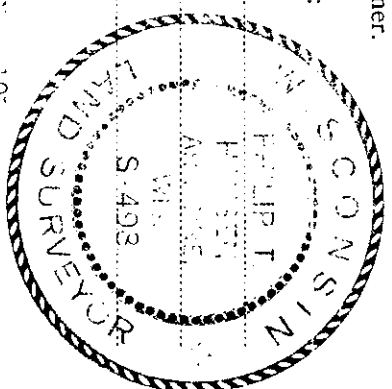

○ = Corner monument restored.

History of original corner establishment:



Description of corner evidence found:





(County Surveyor, Registered Land Surveyor, or other duly authorized official)


Diana Bergey Kuehn
(Register of Deeds)

By Joseph M. Bennett Deputy