

CERTIFIED LAND CORNER RESTORATION

Index No. V-13

State of Wisconsin





Resident witnesses:

Jim J. Hagan

John J. Hagan

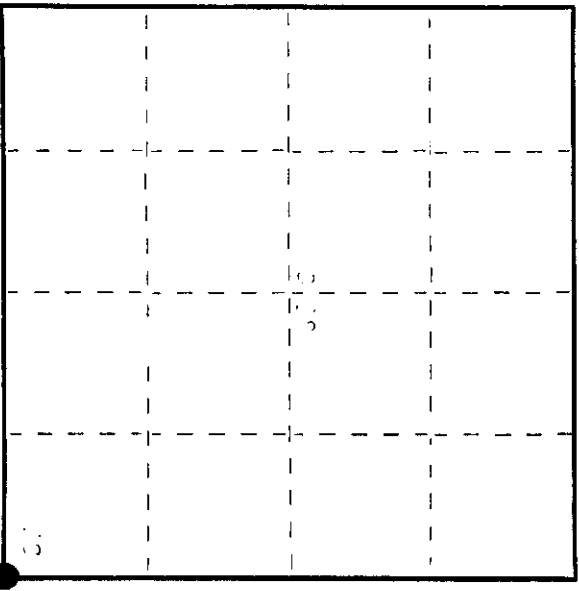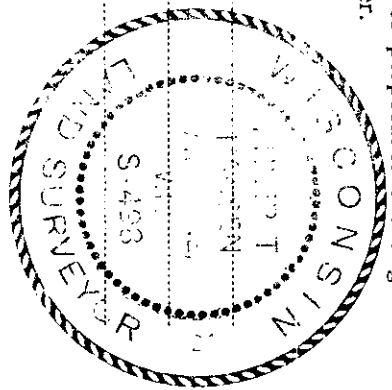

○ = Corner monument restored.

History of original corner establishment:



Description of corner evidence found:


PROV. 1100
S. 36, T. 36 N., R. 34 W.
11705

Description of monument and accessories I established to perpetuate the original location of this corner.

1100 feet from the original corner to the new monument.


(County Surveyor, Registered Land Surveyor, or other duly authorized official)

Instrument was filed in this office for record on the 13th day of December, 1977 at 1:30 o'clock P.M.

Steve Savage
(Register of Deeds)

By George M. Bernier Deputy