

CERTIFIED LAND CORNER RESTORATION


Index No. 7-11

State of Wisconsin


County of Oneida } ss.

I Phillip T. Hansen, do hereby certify that on the 12th day of May, 1977, I found evidence of the C 1/4 corner of Section 28 Township 38, North, Range 10 East, Fourth Principal Meridian, as described hereon; and that from this evidence I established a new monument and accessories as described hereon to perpetuate the original location of this corner.

Resident witnesses:  
Jim Claflin  
Herb Wagoner

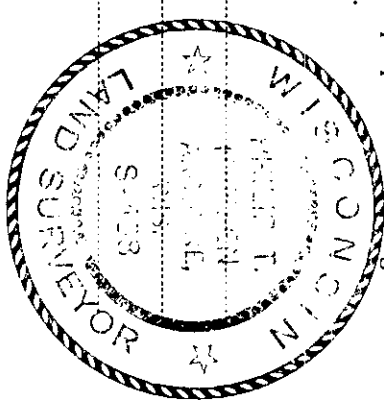

T38N R10E

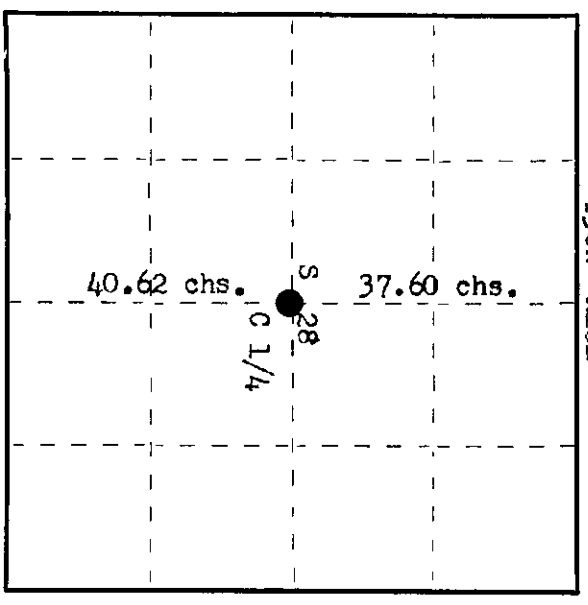

○ = Corner monument restored.

History of original corner establishment:

Original Corner established by D.H. Vaughan, County Surveyor. Corner recovered by N. Loftus, Ripco Surveyor, in 1958. Notes say he ran random line North from S 1/4 corner. At 40.52 hit Vaughan's C 1/4. Post and old FTs in place.

Description of corner evidence found:

Recovered 2" iron pipe with 4" square brass cap, stamped:  
This was recovered in good condition, there was also two old cedar posts next to iron pipe, one identified as Vaughan's, scribed 1 1/4 S.  
Recovered OBTs - Cedar 10" S81°W, 29.9 links, scribed C 1/4 28 BT.  
Cedar 8" N88°E, 13.6 links, scribing grown over.  
T38N R10E  
C 1/4 S28  
R10E

Description of monument and accessories I established to perpetuate the original location of this corner.  
Reset iron pipe deeper in the ground in same hole.  
Monument projects 24" above ground.  
NBT marked - Cedar 6" S53°W, 32.7 links, scribed C 1/4 BT.

Dated at Rhineland, Wis., this 25th day of May, 1977.

Signature Phillip T. Hansen Title Registered Land Surveyor Registration No. S-498  
County Surveyor, Registered Land Surveyor, or other duly authorized official  
Office of Register of Deeds, County of Oneida  
at 10:30 o'clock A.M. day of May, 1977  
I hereby certify that the within

Debra Verage Kuehn  
(Register of Deeds)

By Debra Verage Kuehn Deputy

20 28 28 20 20