

State of Wisconsin




I, Phillip T. Wenzel, do hereby certify that on the 15th day of November, 1977, I found evidence of the North corner of Section 28, Township 28, North, Range 10 East, Fourth Principal Meridian, as described hereon; and that from this evidence I established a new monument and accessories as described hereon to perpetuate the original location of this corner.

Resident witnesses:



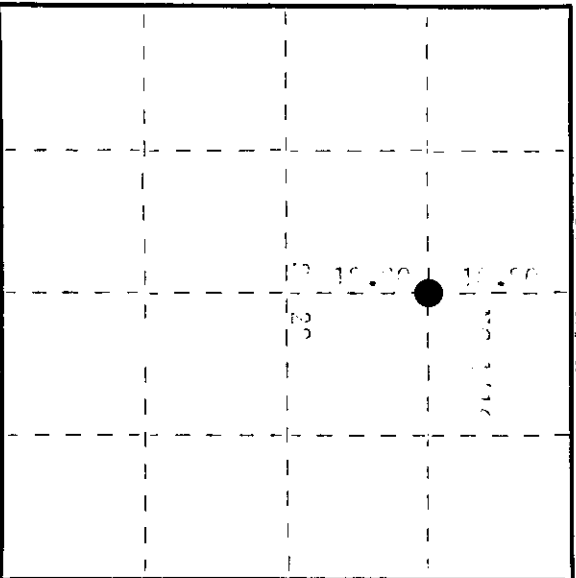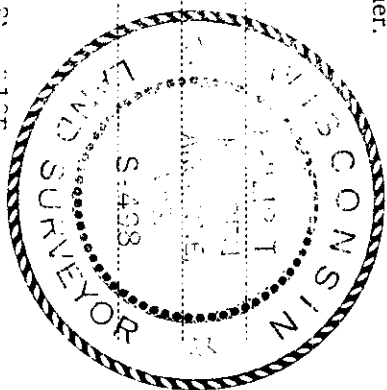

○ = Corner monument restored.

History of original corner establishment:

*[Faint, mostly illegible text describing the history of the original corner establishment.]*

Description of corner evidence found:

*[Faint, mostly illegible text describing the corner evidence found.]*

Description of monument and accessories I established to perpetuate the original location of this corner.



Signature Phillip T. Wenzel Title Registered Professional Land Surveyor Registration No. 4938  
(County Surveyor, Registered Land Surveyor, or other duly authorized official)


James George Kuehn  
(Register of Deeds)

By Deputy M. Boerner Deputy

2811283020