

CERTIFIED LAND CORNER RESTORATION

Index No. V-7

State of Wisconsin

County of Oneida } ss.



I Philip T. Hansen, do hereby certify that on the 18th day of May, 1977, I found evidence of the Quarter corner of Section 29 & 32

Township 38, North, Range 10 East, Fourth Principal Meridian, as described hereon; and that from this evidence I established a new monument and accessories as described hereon to perpetuate the original location of this corner.

Resident witnesses:

Jim Claflin

Herb Wagoner

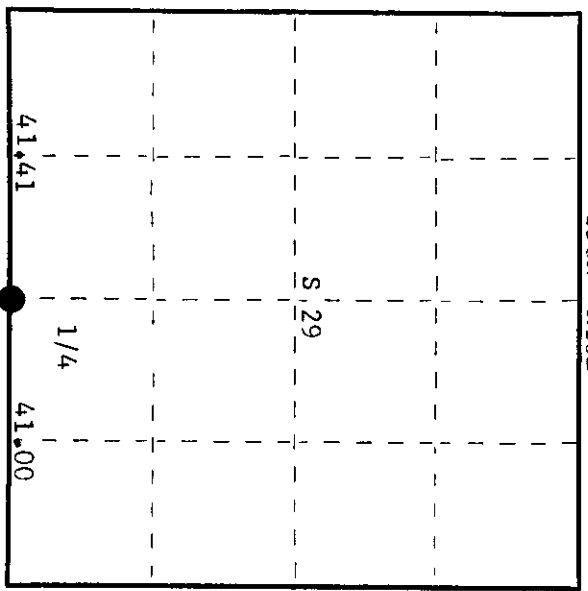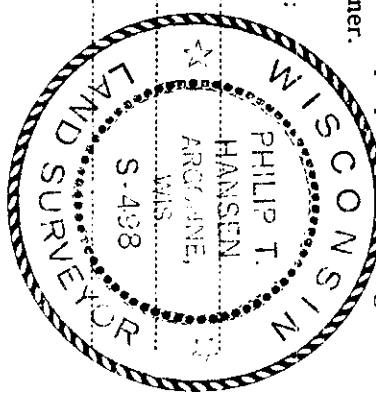

○ = Corner monument restored.

History of original corner establishment:

Corner established by Wm. E. Dougherty, Deputy Surveyor, in 1863, from which Birch 8" bears S58°E, 7 links and Tamarack 8" bears N28°W, 8 links. Corner re-established by N. Loftus, Ripco Surveyor, in 1957. Ran random line east from Section Corner 30, 29, 32 & 31 - bearing S88° 10' E 82.41 chains to close out 1.51 chains south of 28, 29, 33, 32. Established 1/4 corner at 41.41 chains. Marked White Birch 6" N72°W, 56 links and White Birch 8" S33°E, 7 links.

Description of corner evidence found:

Recovered 2" iron pipe with 4" square brass cap, stamped: Monument projects 29" above ground. Monument is loose in ground. Recovered OBTS - White Birch 6" N72°W, 55.0 links, now a stump.

White Birch 8" S36°E, 7.0 links, now a stub, scribed 1/4S S32. T38N R10E  
S 29  
1/4 S + 32  
RIPCO

Description of monument and accessories I established to perpetuate the original location of this corner.

Reset monument at its original location. Marked NBTs - Maple 7" S35°E, 84.1 links  
White Birch 8" S18°E, 97.1 links  
Maple 6" S25°W, 133.4 links, all scribed 1/4 BT.

Dated at Rhineland, Wis., this 8th day of June, 19 77.

Signature: Philip T. Hansen Title Registered Land Surveyor Registration No. S-498  
(County Surveyor, Registered Land Surveyor, or other duly authorized official)

Office of Register of Deeds, County of Oneida. I hereby certify that the within instrument was filed in this office for record on the 23rd day of June, 19 77 at 12:40 o'clock P. M.

Doris Verage Kuehn  
(Register of Deeds)

By: \_\_\_\_\_ Deputy



32/029000