CERTIFIED LAND CORNER RESTORATION

Index No. U-9

State of Wisconsin
County of Oneida } ss.

I Philip T. Hansen, do hereby certify that on the 9th day of March, 19 78, I found evidence of the S 1/16 corner of Section 28 & 29 Township 38, North, Range 10 East, Fourth Principal Meridian, as described hereon; and that from this evidence I established a new monument and accessories as described hereon to perpetuate the original location of this corner.

Resident witnesses:

Jim Claflin

Herb Wagoner

WISCONSIN PHILIP T. HANSEN S-498 LAND SURVEYOR

T38N R10E

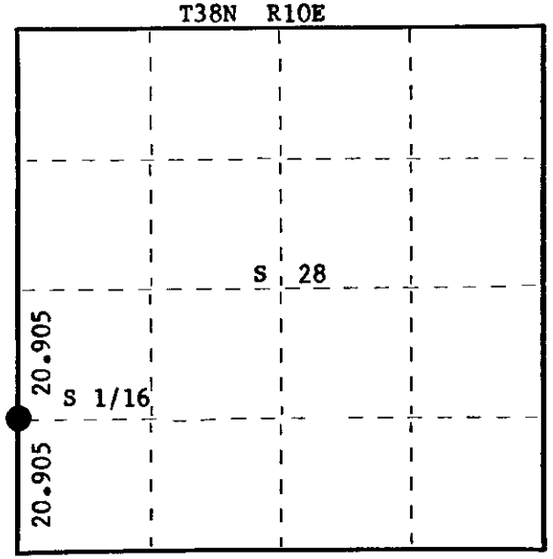

O = Corner monument restored.

History of original corner establishment:

Corner established by Drivas and crew, Ripco surveyors, in 1961.
Ran random line north bearing 357° 1' 30" magnetic, 41.81 chains to close out 69 links west of previously recovered 1/4 corner.
Corrected bearing N 02° 0' 46" W. Set S 1/16 corner at 20.905 chains intermediate.
Marked NBT's - black spruce 5" N12°W, 29 links
black spruce 4" S23°W, 46½ links

Description of corner evidence found:

Recovered 3/4" iron pipe with 2" square brass cap projecting 8" above ground. Cap stamped: Monument recovered in excellent condition. There is also a 3" squared spruce post along side the iron pipe.

Recovered OBT's - black spruce 5" N12°W (N2°E) 29 links, scribed S 1/16 S29 BT.
black spruce 4" S23°W (S29°W) 46.25 links, scribing grown over.

S 1/16
S29 + S28
RIPCO

Description of monument and accessories I established to perpetuate the original location of this corner.

Monument left in place as recovered.
No additional accessories established.

Dated at Rhinelander, Wis., this 13th day of March, 19 78

Signature Philip T. Hansen Title Registered Land Surveyor Registration No. S-498
(County Surveyor, Registered Land Surveyor, or other duly authorized official)

Office of Register of Deeds, County of Oneida, I hereby certify that the within instrument was filed in this office for record on the 5th day of April, 19 78 at 2:30 o'clock P. M.

Doris Verage Kuehn
(Register of Deeds)

By Deputy

FORM 985 H. C. MILLER CO., MILWAUKEE