

CERTIFIED LAND CORNER RESTORATION



Index No. **7-9**

State of Wisconsin

County of Oneida } ss.

I, Phillip T. Hansen, do hereby certify that on the 9th day of March, 1978, I found evidence of the Quarter corner of Section 28 & 29 Township 38 North, Range 10 East, Fourth Principal Meridian, as described hereon; and that from this evidence I established a new monument and accessories as described hereon to perpetuate the original location of this corner.

Resident witnesses:
Jim Claflin
Herb Wagoner

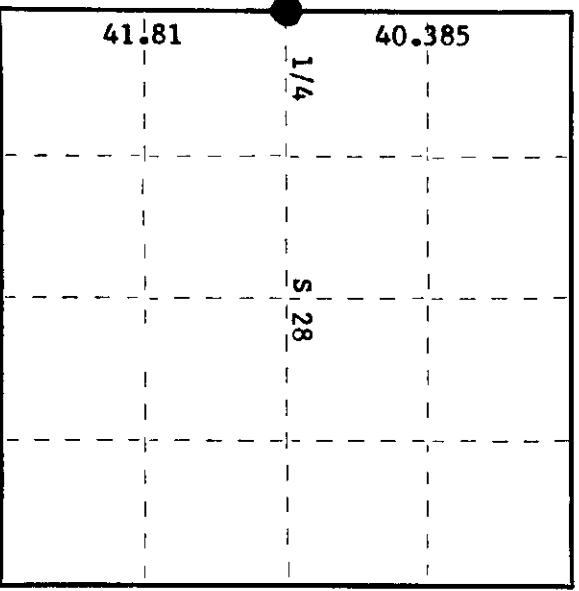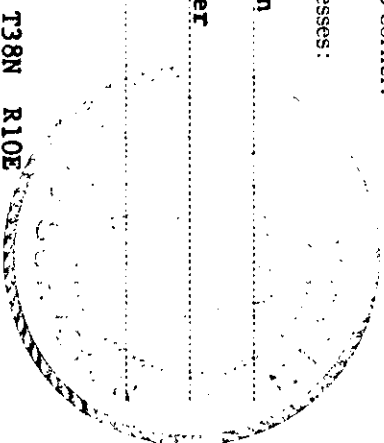

○ = Corner monument restored.

History of original corner establishment:

Original corner established by Wm. E. Dougherty, Deputy Surveyor, in 1863, from which tamarack 10" bears S74°W, 10 links and spruce 10" bears N55°E, 14 links.

Corner recovered by B.H. Dorr who also set N 1/16 corner.

Corner re-established by Drivas and crew, Ripco surveyors, in 1961. Ran random line south from recovered section corner 20, 21, 28 and 29, 20.1925 chains to close out 17-3/4 links west of Dorr's N 1/16 corner. Continued south and re-established 1/4 corner at 40.385 chains. Corrected bearing S2° 58' 30" E. Marked NBT's - tamarack 9" N16°E, 7.0 links and tamarack 7" S48°W, 28 links.

Recovered 2" iron pipe with 4" square brass cap leaning and almost out of ground.
Cap stamped:

Recovered OBT's - tamarack 9" N16°E, 7.0 links, now dead, scribed BT & S28 BT. T38N R10E
tamarack 7" S48°W, 28.0 links, 1/4
S48°W (S57°W) scribed & S29 BT. S29 S28
RIPCO

Description of monument and accessories I established to perpetuate the original location of this corner.
Removed monument and reset it in its original location. Monument now projects 12" above ground.

Marked NBT's - tamarack 8" S4°E, 58.0 links, scribed 1/4 BT.
tamarack 8" S17°W, 51.2 links, scribed 1/4 BT.
tamarack 7" S82°W, 85.8 links, scribed 1/4 BT.

Dated at Rhinelander, Wis., this 13th day of March, 1978

Signature Phillip T. Hansen Title Registered Land Surveyor Registration No. S-498
(County Surveyor, Registered Land Surveyor, or other duly authorized official)

Office of Register of Deeds, County of Oneida, I hereby certify that the within instrument was filed in this office for record on the 5th day of April, 1978 at 2:30 o'clock P. M.

Doris Bernice Fuchler
(Register of Deeds)

By _____ Deputy

3210292000