

State of Wisconsin



County of Oncida } ss.

I Phillip T. Hansen, do hereby certify that on the 23rd day of September, 1977, I found evidence of the NC 1/16 corner of Section 20 Township 3°, North, Range 10 East, Fourth Principal Meridian, as described hereon; and that from this evidence I established a new monument and accessories as described hereon to perpetuate the original location of this corner.

Resident witnesses:

Jim Clafflin

Herb Macorner

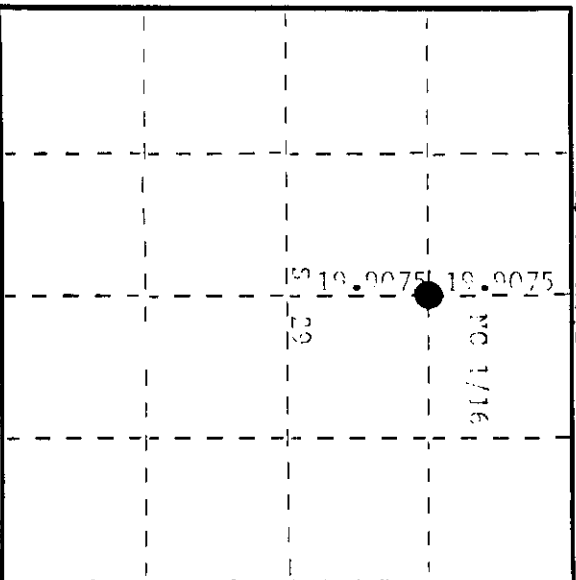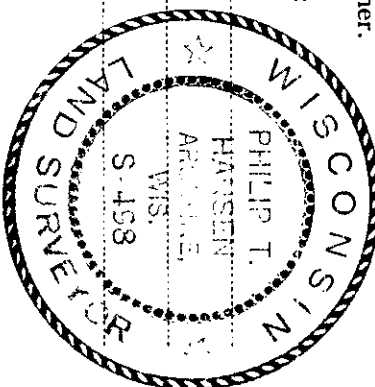

O = Corner monument restored.

History of original corner establishment:

Corner established by Gaddard and crew, Ripco Surveyors, in 1961. Pan N-S 1/4 line and E-W 1/2 line to establish the C 1/4 corner. Set NC 1/16 at 19.9075 chains intermediate. Corrected bearing N 2° 29' 30" W. Picked PTs - Maple 40' x 41', 21 links  
Maple 40' x 53', 22 links

Description of corner evidence found:

Recovered 60' square ash post in fair condition, not secured. Recovered CBTs - Maple 40' x 41', 21.0 links, scribbles not legible. Maple 40' (50') x 53', (54') 22.0 links.

Description of monument and accessories I established to perpetuate the original location of this corner.

Set a 1" iron pipe with 2" brass cap in place of the recovered ash post. Monument projects 24" above ground. Cap stamped: no additional accessories established.

T30th R10E

NC 1/16 **S-7**

CPI-1977

Dated at Phirelander, Wis., this 27th day of September, 1977

Signature: Phillip T. Hansen Title: Registered Land Surveyor Registration No. S-458  
(County Surveyor, Registered Land Surveyor, or other duly authorized official)

Office of Register of Deeds, County of Oncida Thereby certify that the within instrument was filed in this office for record on the 18th day of October, 1977 at 9:15 o'clock A. M.

Doree Savage Kuehn  
(Register of Deeds)

By: \_\_\_\_\_ Deputy