

CERTIFIED LAND CORNER RESTORATION



Index No. 7-5

State of Wisconsin }  
 County of Oneida } ss.

I, Philip T. Hansen, do hereby certify that on the 27th day of August, 1979, I found evidence of the Quarter corner of Sections 30 and 29 Township 38 North, Range 10 East, Fourth Principal Meridian, as described hereon; and that from this evidence I established a new monument and accessories as described hereon to perpetuate the original location of this corner.

Resident witnesses:

Glen Parker  
 Jim Claflin  
 Herb Wagoner

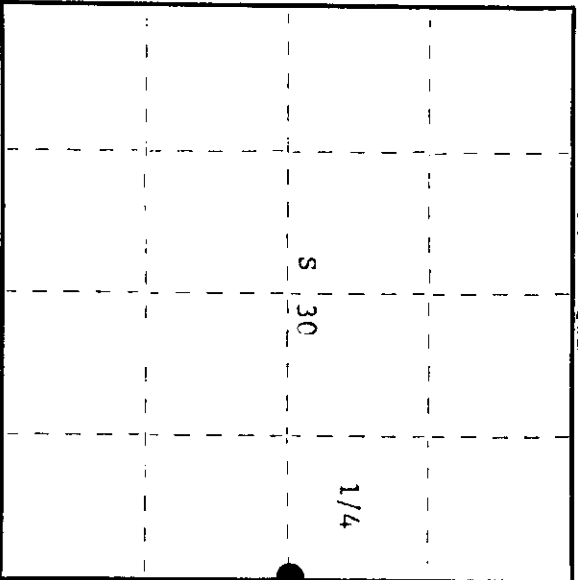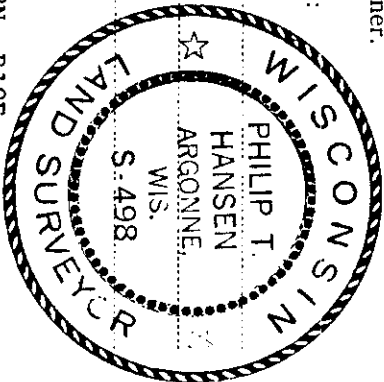

○ = Corner monument restored.

History of original corner establishment:

Corner established by Wm. E. Dougherty, Deputy Surveyor, in 1863, from which spruce 13" bears S35°E 15 links; tamarack 12" bears N16°W 10 links. Corner re-established by Ripco surveyors by running from the N 1/16 between sections 30 and 29 to the S 1/16 which they had reason to believe had been moved. Drove 2" x 4" pipe in ground, 6" below the surface. B.O. - Power Fole, S86°E C.91 chains; RT-Elm 18" S14°E 1.71 chains.

Description of corner evidence found:

Recovered their 2" iron pipe with 4" squared brass cap buried 6" below the surface of a field. Cap stamped:  
 Recovered OBT - Elm 18" (24") S14°E 1.71 chains  
 Power Fole S8°E 91 links

T38N R10E  
 1/4 S30+ S29

Description of monument and accessories I established to perpetuate the original location of this corner:  
 Set a 2-1/2" Berritsen A-1 Federal Monument for witness corner 130 links west.  
 Monument projects 12" above ground. Cap stamped:  
 Because of open field no opportunity for BO or NBT.

T38N R10E  
 1/4 S30+ S29 W.C.

Dated at Rhinelander Wis, this 3rd day of September, 1979

Signature Philip T. Hansen Title Registered Land Surveyor Registration No. S-498  
 (County Surveyor, Registered Land Surveyor, or other duly authorized official)

Office of Register of Deeds, County of Oneida  
 at 10:50 o'clock M. 17th day of September, 1979  
 I hereby certify that the within

Signature Doris Leverage Fischer  
 (Register of Deeds)

By Deputy

330302000