

CERTIFIED LAND CORNER RESTORATION

Index No. **Z-5**

State of Wisconsin

County of Oneida } ss.

I Phillip T. Hansen, do hereby

certify that on the 9th day of March, 1978, I found

evidence of the Section corner of Sections 5, 6, 31, 32



Township 37 & 38, North, Range 10 East, Fourth Principal Meridian,

as described hereon; and that from this evidence I established a new monument and accessories as described hereon to perpetuate the original location of this corner.

Resident witnesses:

Jim Clafflin

Herb Wagoner

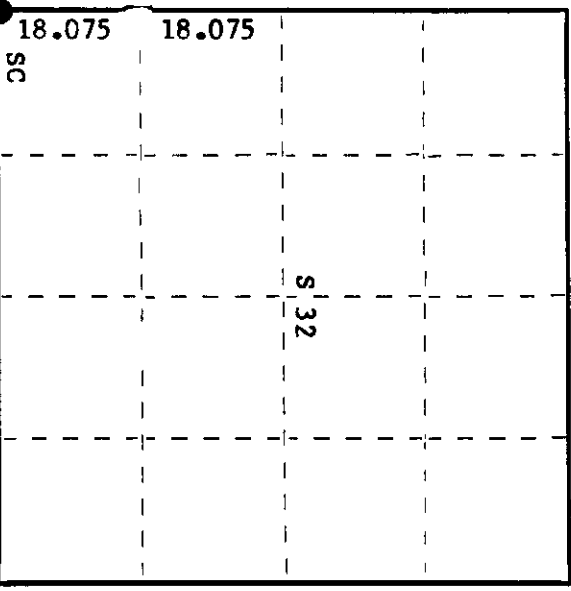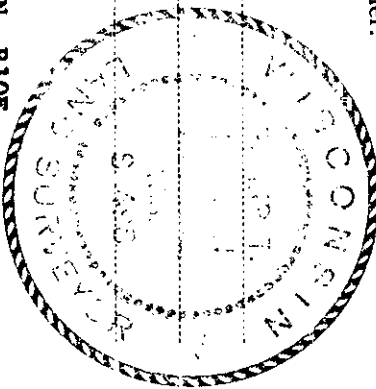

○ = Corner monument restored.

History of original corner establishment:

Original corner established by Hiram C. Fellows, Deputy Surveyor, from which white pine 10" bears N81°W, 26 links; birch 7" bears N53°E, 20 links; birch 10" bears S3°E, 6 links; birch 12" bears S73°W, 33 links.

N. Loftus recovered Dorr's S 1/16 corner between sections 31 & 32 in 1959. Set new post and marked NBT's. Ran random line south from W 1/4 corner 18.075 chains to tie into S 1/16 corner. Corrected line and set sections corner 31, 32, 5 & 6 at 36.15 chains. Marked NBT's - white spruce 8" S88°E, 25½ links tamarack 7" N28°W, 1.16 chains

Description of corner evidence found:

Recovered 2" iron pipe with 2" square brass cap in excellent condition projecting 12" above ground. Cap stamped:

Recovered OBT's - tamarack 7" N28°W, 1.16 chains, 38-10 S31 S32  
 now a stump, scribed BT. S6 S5  
 white spruce 8" S88°E, 25.5 links 37-10 RIP00  
 (26.5 lks), scribed S5, T37 R10E BT.

Description of monument and accessories I established to perpetuate the original location of this corner.

Monument left in place as recovered.

Marked NBT's - Maple 6" S7°E, 50.7 links, scribed SC-BT.  
 Maple 10" S22°W, 68.0 links.  
 Black Spruce 7" S89°W, 58.0 links.

Dated at Rhineland, Wis., this 13th day of March, 1978

Signature Phillip T. Hansen Title Registered Land Surveyor Registration No. S-498  
 (County Surveyor, Registered Land Surveyor, or other duly authorized official)

Office of Registrar of Deeds, County of Oneida, I hereby certify that the within instrument was filed in this office for record on the 5th day of April, 1978 at 2:30 o'clock P. M.

Doree LePage Fischer  
 (Register of Deeds)

By \_\_\_\_\_ Deputy

387031000