

This form is intended to fulfill requirements of Chapter A-E 7.08 (3)(a) thru (f) U.S. Public Land Survey Monument Location Record, Wisconsin Administrative Code. Use reverse side for geodetic location data and/or other continuation purposes.

U.S. PUBLIC LAND SURVEY MONUMENT LOCATION RECORD

Recorders Data

USPLS CORNER: NORTH 1/4 CORNER SECTION: 6 TOWNSHIP: 37 NORTH RANGE: 10 EAST

NAME OF WATERWAY FOR M.C. CORNER: N/A SECTION LINE: N/A

(CITY)(VILLAGE)(TOWN) OF: STELLA COUNTY OF: ONEIDA

Description of monument found or placed and all other evidence used as the basis for monument location; including monuments and related measurements required if the corner location was reestablished by lost corner proportionate methods. Also indicate name of original surveyor, original survey date and the corner monument, bearing trees, witness or other reference monuments established; including measured bearing and distance ties, from available records.

Found and accepted an old rusty 1.5" dia. iron pipe monument with RIPCO stamped 1/4" by 3" square steel plate cap lying nearly flat to West on surface of existing bog/marsh, which I carefully replumbed to reveal soil cavity at base of the iron pipe, where it had apparently been set. I then carefully pulled the old iron pipe and replaced it with a standard 2" dia. by 60" long aluminum pipe monument with stamped Oneida County cap 12" above matted down surface of grass in bog/marsh area. I left old iron pipe flat on grade next to new corner monument set.

In 1859, H.C. Fellows/GLO set a wood post as the original corner and marked OBTs, a 12" Spruce N03°W 19 lks and a 12" Spruce S18°W 6 links, all of which are now obliterated or indeterminate for locational purposes.


In 1898, B.F. Dorr noted a wood post at corner; no ties.

In 1915, Vaughn found old wood post at corner and noted NW OBT as dead and SW OBT as stump OK; all of which are now gone or indeterminate for locational purposes.

In 1936, Hall & Hassler found Dorr's 5" sq. Spruce post and both BTs, now gone; and noted new BTs, a 5" Spruce N09°E 0.22 chains, now gone, and a 4" Spruce S41.5°W 0.27 chains, which I found as a dead 8" Spruce 4.5' high stub with upper and lower face blazes open with scribing, S43°W 17.3', which I believe verifies the corner location now found.

This recovery completed May 5, 1999; there were no witnesses.

Plan view map of monument location with bearing and distance ties to a minimum of four(4) described witness or reference monuments of concrete, natural stone, iron, live bearing trees or equivalent material. If applicable, also show a minimum of two(2) bearing and distance ties to any other monument found and not accepted; including the bearing and distance from the accepted monument.

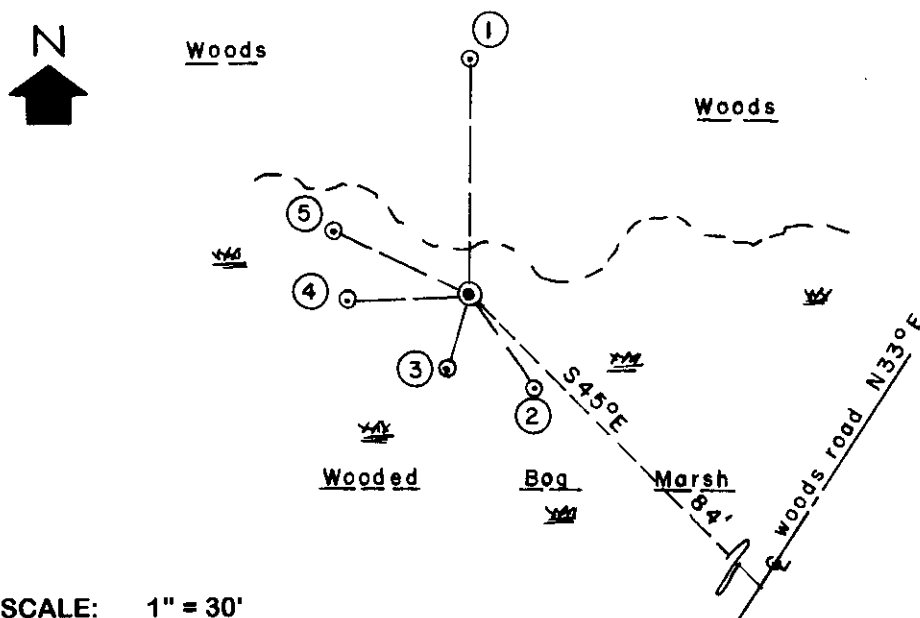

WITNESS MONUMENT TIES:

- ① New BT 8" Spruce North 37.00'.
- ② New BT 7.5" Spruce S33°E 17.98'.
- ③ New BT 5.5" Spruce S18°W 11.88' with standard aluminum locator tag on SW face 6" high.
- ④ New BT 7.5" Spruce S87°W 19.06'; East trunk of two.
- ⑤ New BT 8" Spruce N65°W 23.43'.


Corner is N45°W 84' from center of a woods road bearing N33°E.

Standard white poly'T' marker post set 9" North of corner monument.

SCALE: 1" = 30'

Unless otherwise indicated, all bearing tree ties are to a .25" dia. by 2.5" long PK nail with a 1.25" dia. steel washer driven into unblazed right face and a .25" dia. by 2.5" long PK nail is also driven into unblazed face of bearing tree at DBH; the basis for measured bearings is by magnetic compass to nearest degree and all tie distances are measured horizontal by steel tape corrected to nearest 1/100th feet at standard temperature of 68 degrees Fahrenheit.


RLS SEAL:

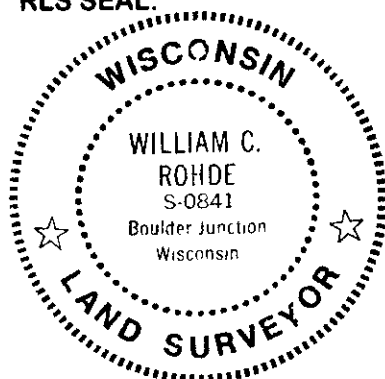

LAND SURVEYOR CERTIFICATE:

I, William C. Rohde, hereby certify that I am duly licensed as a Professional Land Surveyor in the State of Wisconsin; that this USPLS monument location was determined by me and/or under my direct supervision and control; and that this U.S. Public Land Survey Monument Location Record is true and correct to the best of my knowledge and belief.

Signed: *William C. Rohde*
William C. Rohde RLS 841

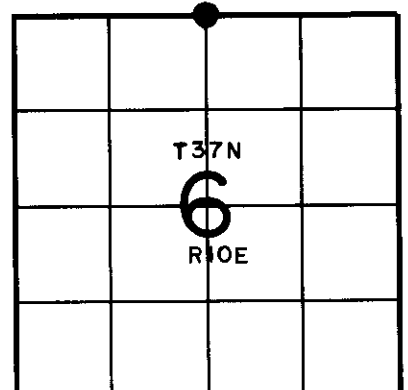

SECTION LOCATION MAP

INDEX NO. A-3
3810310020