

CERTIFIED LAND CORNER RESTORATION

Index No. A-9

State of Wisconsin }
County of Oneida } ss.


I, Philip T. Hansen, do hereby certify that on the 19th day of October, 1979, I ~~found~~ established ~~the~~ corner of Sections 32, 33, 4 and 5 Township 37 E 38, North, Range 10 East, Fourth Principal Meridian, as described hereon; and that from this evidence I established a new monument and accessories as described hereon to perpetuate the original location of this corner.

Resident witnesses:

Jim Claflin

Herb Wagoner

FORM 985 H. C. MILLER CO., MILWAUKEE

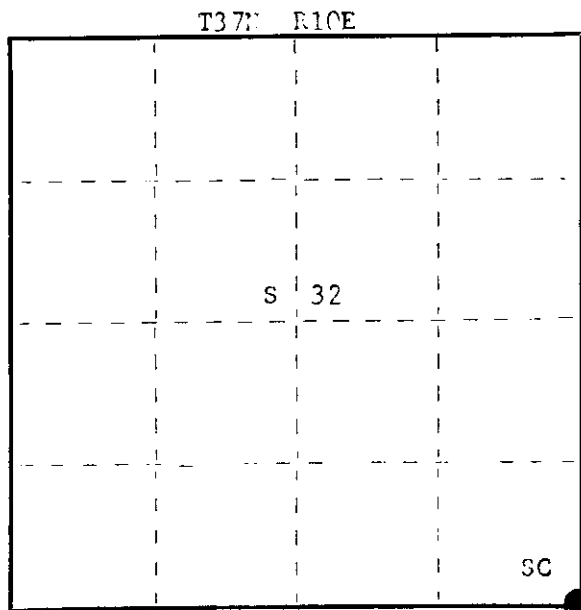

○ = Corner monument restored.

History of original corner establishment:

Original corner established by Hiram Fellows in 1960.
No records of any subsequent survey.

Description of corner evidence found:

No evidence of any corner recovered. Corner sets in a plowed field. Established corner by running traverse between 1/4 corner between sections 32 and 33 south to S 1/16 corner between sections 32 and 33. Both corners by Rince surveyors computed distance 1294.44 feet at bearing S 1° 02' 45" W. Set section corner S 1° 02' 45" W. a distance of 1294.44 feet. This falls in an open productive field.

Description of monument and accessories I established to perpetuate the original location of this corner.

Set a 2-1/2" Berntsen A-1 Federal Monument 2' below ground level. Cap stamped:
No BT's available.

S498 - 1070
T38N R10E
SC $\frac{32+33}{5+4}$
T37N R10E

Dated at Rhineland, Wis., this 17th day of December, 1979

Signature Philip T. Hansen Title Registered Land Surveyor Registration No. S-498
(County Surveyor, Registered Land Surveyor, or other duly authorized official)

Office of Register of Deeds, County of Oneida, I hereby certify that the within instrument was filed in this office for record on the 14th day of January, 1980 at 1:30 o'clock P M.

Loris Verge Kuehn
(Register of Deeds)

By..... Deputy

381032000

