

State of Wisconsin



County of Creida } ss.

I, Phillip T. Hansen, do hereby certify that on the 23rd day of September, 1977, I found evidence of the TC 1/16 corner of Section 32 Township 38 North, Range 10 East, Fourth Principal Meridian, as described hereon; and that from this evidence I established a new monument and accessories as described hereon to perpetuate the original location of this corner.

Resident witnesses:

Jim Clafflin

Herb Wagner

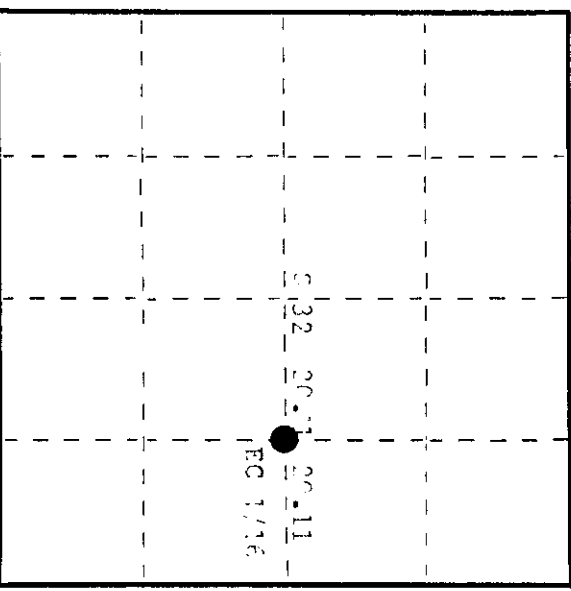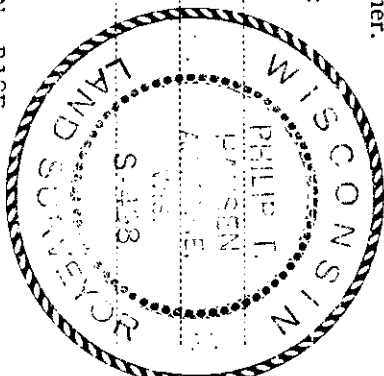

O = Corner monument restored.

History of original corner establishment:

Corner established by N. Loftus, Ripco surveyor, in 1957. Ran random line east from recovered P.F. Dorr Ct. corner 40.22 chains to close out 1.10 chains south of E1 corner. Set EC 1/16 at 20.11 chains interredible. Marked MBTs - Red Maple on S34 8/4, 55-3/4 links. Red Maple on N26 1/4, 65 links. Corrected bearing N 88 20' E.

Description of corner evidence found:

Recovered 1" iron pipe with 2" square brass cap in excellent condition. Cap stamped: Recovered GBTs - Maple on S34 8/4, 55.75 links (5.2 links), scried CI 1/16 S32 BT. Maple on (on) N26 1/4, 65.0 links (5.5 links), scried CE 1 16 S32 BT. Monument in feet's 20" above ground. CE 1/16 5 23

Description of monument and accessories I established to perpetuate the original location of this corner. No additional accessories established.

Dated at Milwaukee, Wis., this 27th day of September, 1977.


Office of Register of Deeds, County of Creida. Instrument was filed in this office for record on the 12th day of October, 1977 at 9:15 o'clock A.M. I hereby certify that the within

By: *Donna Terese Fuchs* (Register of Deeds) Deputy