

CERTIFIED LAND CORNER RESTORATION



Index No. X-7

State of Wisconsin

County of Oneida } ss.

I Phillip T. Hansen, do hereby certify that on the 18th day of May, 1977, I found evidence of the C 1/4 corner of Section 32 Township 38 North, Range 10 East, Fourth Principal Meridian, as described hereon; and that from this evidence I established a new monument and accessories as described hereon to perpetuate the original location of this corner.

Resident witnesses:
Jim Clafin
Herb Wagoner

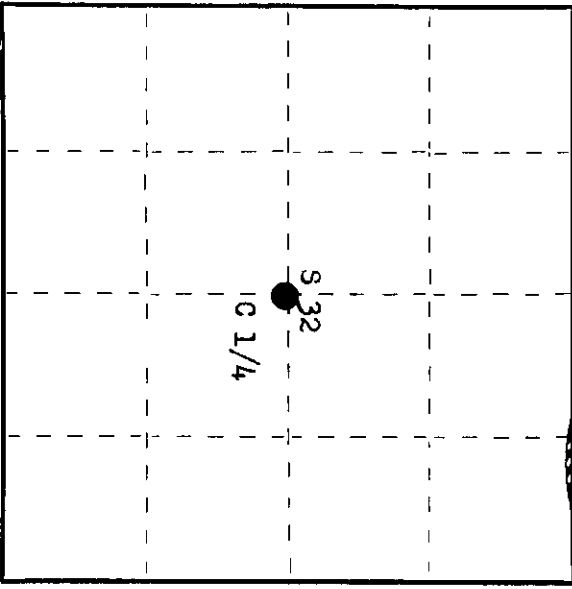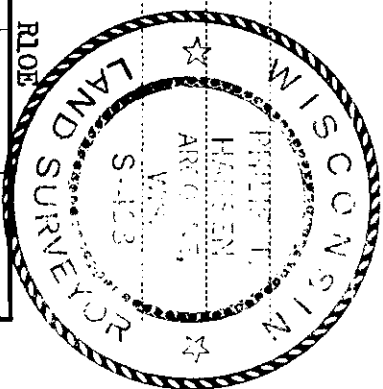

History of original corner establishment:
Corner established by B.F. Dorr, County Surveyor.
Corner recovered by N. Loftus, Ripco Surveyor. Found Dorr's corner and BTs intact.
Set new iron pipe and marked NBTs - Black Spruce 8" N62°W, 25.4 links
Black Spruce 7" N11°E, 26.8 links

Description of corner evidence found:
Recovered 2" iron pipe with 4" square brass cap in good condition and firmly in ground.
Cap stamped:
Recovered OBTs - Black Spruce 8" N62°W, 25.4 links, scribed C 1/4 S32 BT.
Black Spruce 7" N11°E, 26.8 links, scribed C 1/4 S32 BT.
Black Spruce 8" S20°E, 16.7 links
T38N R10E
C 1/4 S32
RIPCO

Description of monument and accessories I established to perpetuate the original location of this corner.
As monument was recovered in good condition, it was left in place.
Monument projects 12" above ground.
No additional accessories established.

Dated at Rhinelander, Wis., this 26th day of May, 1977

(County Surveyor, Registered Land Surveyor, or other duly authorized official)

Office of Register of Deeds, County of Oneida
at 10:30 o'clock P.M. on the 30th day of June, 1977
I hereby certify that the within

Signature: Lorna Bernice Kuehn, Register of Deeds

O = Corner monument restored.

By: Deputy

200 200 200