

CERTIFIED LAND CORNER RESTORATION

Index No. Z-10

State of Wisconsin }
County of Oneida } ss.


History of original corner establishment:
No records of any previous survey.

I, Philip T. Hansen, do hereby certify that on the 13th day of November, 1979, I found ~~restored~~ the corner of Sections 33 and 4 Township 37 & 38, North, Range 10 East, Fourth Principal Meridian, as described hereon; and that from this evidence I established a new monument and accessories as described hereon to perpetuate the original location of this corner.

Resident witnesses:


Jim Clafflin

Herb Wegoner

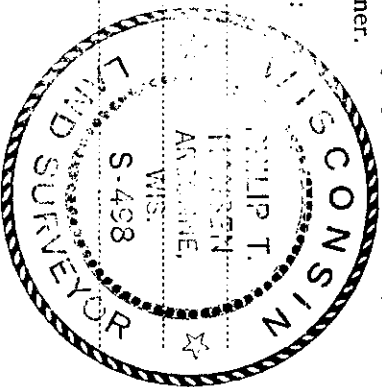

Description of monument and accessories I established to perpetuate the original location of this corner.
Set a 2-1/2" Perntsen A-1 Federal Monument (GTI) 2 feet below surface. Cap stamped:
Nothing available for ET's.

S499-1979
T38N R10E
W 1/16 S 33/4
T37N R10E

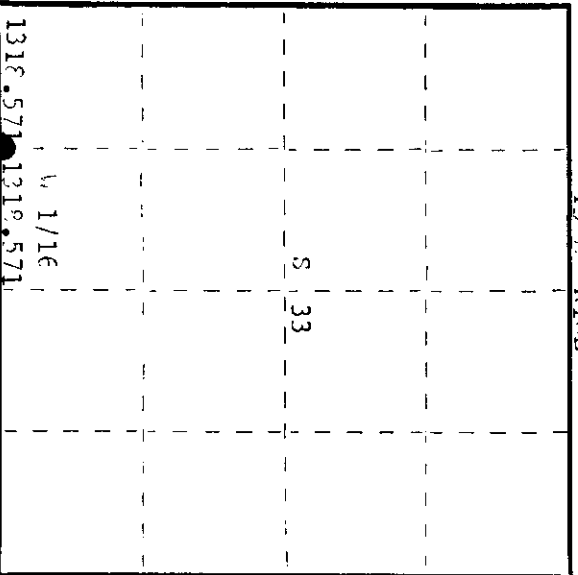

○ = Corner monument restored.

Description of corner evidence found:

No evidence of any corner recovered.
Ran traverse from recovered corner 37, 33, 4 and 5, west to 1/4 corner between sections 33 and 4. Computed distance 2637.143 feet at bearing S 87° 46' 20" E.
Set w 1/16 at 1319.571 feet intermediate. This falls in an open productive field.

Dated at Rhinelander, Wis., this 17th day of December, 1979

Signature: *Philip T. Hansen* Title: Registered Land Surveyor Registration No. S-498
(County Surveyor, Registered Land Surveyor, or other duly authorized official)

Office of Register of Deeds, County of Oneida
Instrument was filed in this office for record on the 14th day of January, 1980
at 1:30 o'clock P.M.

Toni Wenger
(Register of Deeds)

By: _____ Deputy