

CERTIFIED LAND CORNER RESTORATION

Index No. **X-12**

State of Wisconsin



County of Oncida } ss.

I, Phillip T. Hansen, do hereby certify that on the 30th day of September, 1977, I found evidence of the FC 1/16 corner of Section 32 Township 38, North, Range 10 East, Fourth Principal Meridian, as described hereon; and that from this evidence I established a new monument and accessories as described hereon to perpetuate the original location of this corner.

Resident witnesses:

Jim Claffin

Herb Spencer

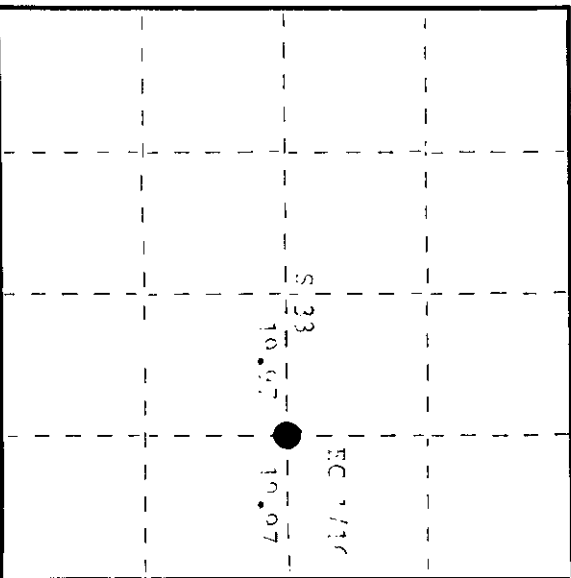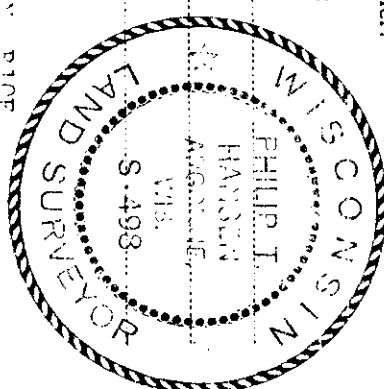

○ = Corner monument restored.

History of original corner establishment:

Corner established by T. Laffin, Risco Surveyor, in 1956. Ran westerly line 799' 20" E from N 1/4, Section 32, 30.34' of line to close at 1.27' of line south of E 1/4 corner. Corrected line to establish the C 1/4 corner. Set FC 1/16 on corrected bearing S 90° 14' E at 19.97' claims intermediate. Marked posts - Red Maple 60' north, 35' links North on 210°T, 35' links

Description of corner evidence found:

Recovered in iron pipe with 2" brass cap, monument to a Lodly Vert, having been run over with a log skidder. Recovered CTR - Maple 60' (NW) 35' S, scribbling 'TRAP OVER' marked on 210°T, 35' links; has been cut, only stump remaining.

Description of monument and accessories I established to perpetuate the original location of this corner.

Replaced pipe's with iron pipe with 1" brass cap for setting 19" above ground. Cost of work: \$400. Vertical post - Sugar 60' north, 11.5' links, corrected 1/16' pt. T39N R10E FC 1/16 S 33 423 CT-1977

Dated at Phinno, Wis., this 30th day of October, 1977


Office of Register of Deeds, County of Oncida I hereby certify that the within instrument was filed in this office for record on the 17th day of November, 1977 at 2:12 o'clock P.M.

Steve Savage Kuehn (Register of Deeds)

By Joseph M. Berner Deputy

3810332010