

State of Wisconsin

County of Creda



} ss.

I Phillip T. Hansen, do hereby certify that on the 30th day of September, 1977, I found evidence of the NE 1/4 corner of Section 23 Township 3S, North, Range 10 East, Fourth Principal Meridian, as described hereon; and that from this evidence I established a new monument and accessories as described hereon to perpetuate the original location of this corner.

Resident witnesses:

Jim Claffin

Herb Hagerer

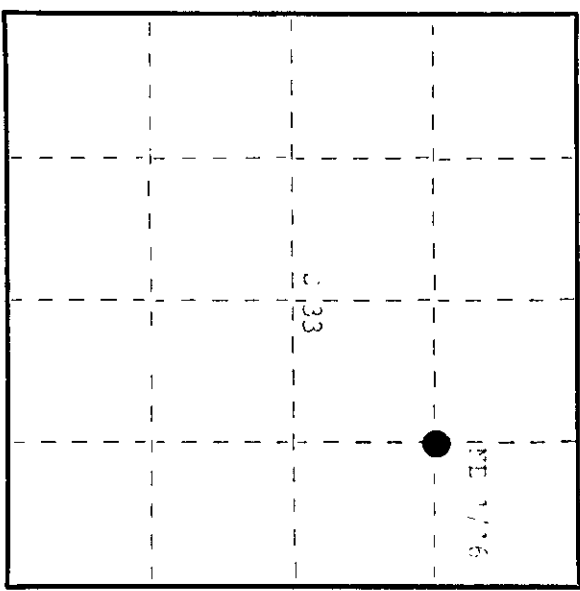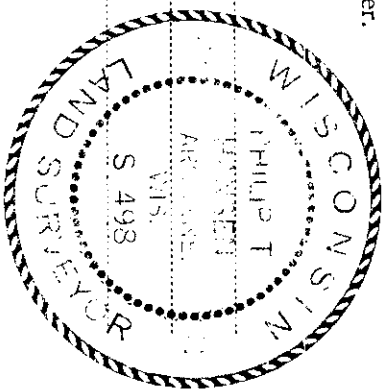

○ = Corner monument restored.

History of original corner establishment:

Corner established by W. Loftus, Tippecanoe Surveyor, in 1856. Far north line 56' 30" E from previously established R 1/4 E corner of north line, 37.715 chains, to close out 1st line west of EC 1/4 E corner. Set NE 1/4 corner at 18.957' chains, interpolate on true line. Corrected bearing 86° 30' E. Marked with - Sugar Maple 20' 05" 23' 9" links Yellow Birch 6" 18" E, 57' links

Description of corner evidence found:

Recovered 2nd Iron pipe with 70' square base cap, stamped: Monument 18' 1/2' above ground, recovered in excellent condition. Recovered CRTS - Sugar Maple 20' 05" (110' 55" (N170°E) 8' 0" links (6.7 lbs) Yellow Birch 6" 18" (65' 0") 25' 0" links, from 1st line (18.957').

Description of monument and accessories I established to perpetuate the original location of this corner.

Monument was left as recovered. Monument - Sugar Maple 20' 05" 23' 9" links, set on 1/4 E 1/4 NE.

Dated at Plainfield, Wis., this 21st day of October, 1977.

(County Surveyor, Registered Land Surveyor, or other duly authorized official)

Office of Register of Deeds, County of Creda. I hereby certify that the within instrument was filed in this office for record on the 17th day of November, 1977 at 2:10 o'clock P. M.

David Savage Tenker
(Register of Deeds)

By Joseph M. B. Garner Deputy