CERTIFIED LAND CORNER RESTORATION

Index No. Z-14

State of Wisconsin
County of Oneida } ss.

I [illegible], do hereby certify that on the [illegible] day of October, 1977, I found evidence of the [illegible] 1/16 corner of Section [illegible] Township [illegible], North, Range [illegible] East, Fourth Principal Meridian, as described hereon; and that from this evidence I established a new monument and accessories as described hereon to perpetuate the original location of this corner.

Resident witnesses:
[illegible]
[illegible]

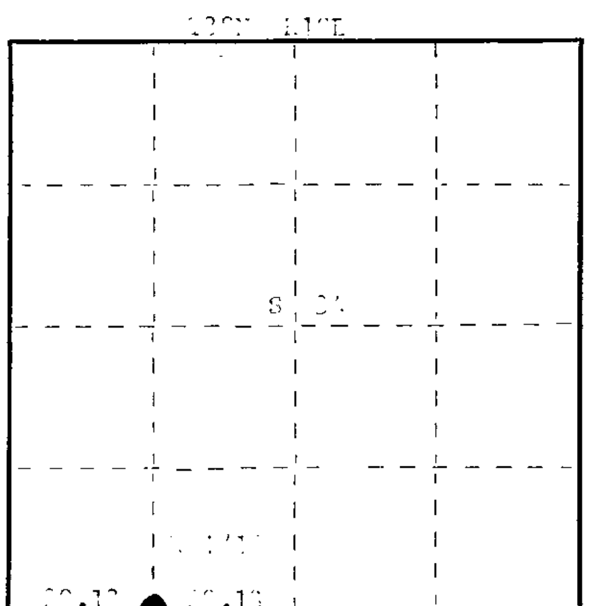

○ = Corner monument restored.

History of original corner establishment:
[illegible]

Description of corner evidence found:
[illegible]

Description of monument and accessories I established to perpetuate the original location of this corner.
[illegible]

Dated at [illegible], Wis., this [illegible] day of [illegible], 1977

Signature Philip J. Hansen Title [illegible] Registration No. [illegible]
(County Surveyor, Registered Land Surveyor, or other duly authorized official)

Office of Register of Deeds, County of [illegible], I hereby certify that the within instrument was filed in this office for record on the 12th day of December, 1977 at 11:00 o'clock a M.

Doris Verage Kuehn
(Register of Deeds)

By Joseph M. Boomer Deputy

FORM 985 H. C. MILLER CO., MILWAUKEE

3810340030