

CERTIFIED LAND CORNER RESTORATION



Index No. **Y-16**

State of Wisconsin


I, W. E. Patten, do hereby certify that on the 30th day of October, 1977, I found evidence of the SE 1/4 corner of Section 27 Township 28 North, Range 10 East, Fourth Principal Meridian, as described hereon; and that from this evidence I established a new monument and accessories as described hereon to perpetuate the original location of this corner.

Resident witnesses:
.....
.....

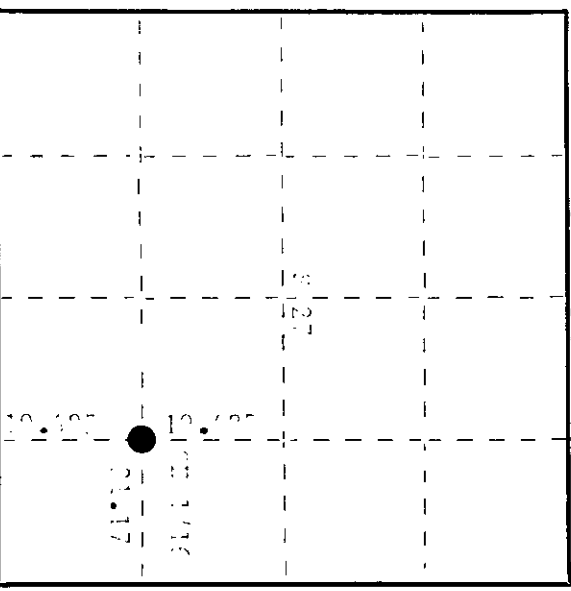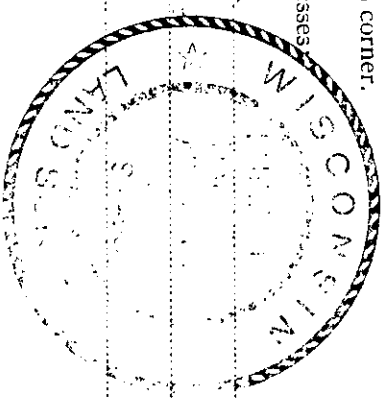

○ = Corner monument restored.

History of original corner establishment:


Description of monument and accessories I established to perpetuate the original location of this corner.

No additional accessories established.


(County Surveyor, Registered Land Surveyor, or other duly authorized official)

I hereby certify that the within instrument was filed in this office for record on the 13th day of December, 1977 at 11:02 o'clock A. M.

James George Kuehn
(Register of Deeds)

By Joseph M. Boomer Deputy