CERTIFIED LAND CORNER RESTORATION

Index No. X-15

State of Wisconsin } ss.
County of [illegible]

I [illegible], do hereby certify that on the [illegible] day of [illegible], 19[illegible], I found evidence of the [illegible] corner of [illegible] Township [illegible], North, Range [illegible], Fourth Principal Meridian, as described hereon; and that from this evidence I established a new monument and accessories as described hereon to perpetuate the original location of this corner.

Resident witnesses:

[illegible]

[illegible]

WISCONSIN
[illegible]
S-493
LAND SURVEYOR

[illegible]

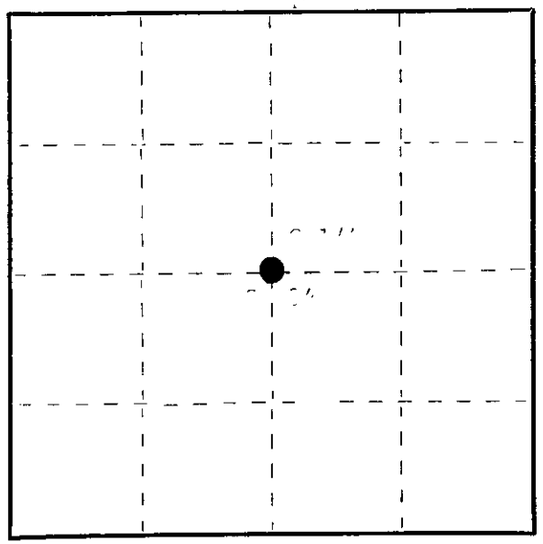

○ = Corner monument restored.

History of original corner establishment:

[illegible]

Description of corner evidence found:

[illegible]

Description of monument and accessories I established to perpetuate the original location of this corner.

[illegible]

Dated at [illegible], Wis., this [illegible] day of [illegible], 19[illegible].

Signature Philip T. Hansen Title [illegible] Registration No. [illegible]
(County Surveyor, Registered Land Surveyor, or other duly authorized official)

Office of Register of Deeds, County of [illegible], I hereby certify that the within instrument was filed in this office for record on the 15th day of December, 1977 at 1:30 o'clock P. M.

Doris Verage Kuehn
(Register of Deeds)

By Joseph M. Boomer Deputy

FORM 983 W. C. MILLER CO., MILWAUKEE

339034