

CERTIFIED LAND CORNER RESTORATION

Index No. **W-15**

State of Wisconsin




I, Phillip T. Anderson, do hereby certify that on the 20th day of October, 19 77, I found evidence of the 1/2 Section 34 corner of Section 34 Township 30 North, Range 10 East, Fourth Principal Meridian, as described hereon; and that from this evidence I established a new monument and accessories as described hereon to perpetuate the original location of this corner.

Resident witnesses:

Mr. G. Hill

Mr. Anderson

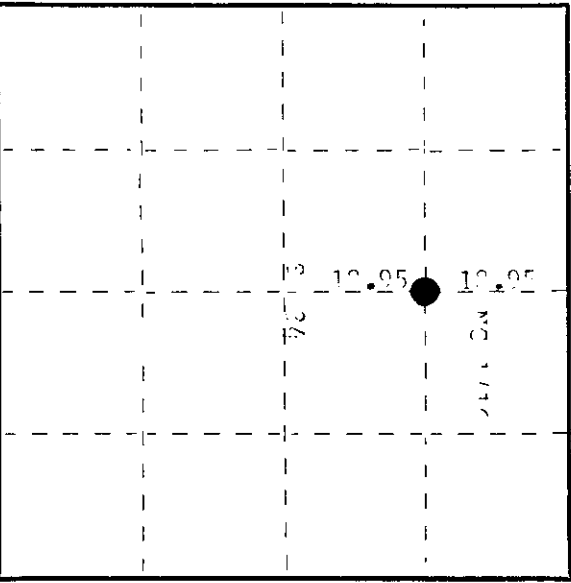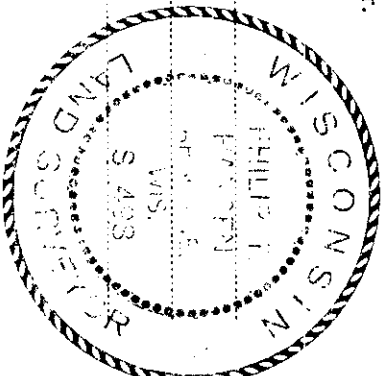

○ = Corner monument restored.

History of original corner establishment:


Description of corner evidence found:


Description of monument and accessories I established to perpetuate the original location of this corner.



(County Surveyor, Registered Land Surveyor, or other duly authorized official)


Thomas George Tucker
(Register of Deeds)

By Joseph M. Boerner Deputy