

State of Wisconsin



County of Oneida } ss.

I, Philip T. Starnam, do hereby certify that on the 11th day of October, 1977, I found evidence of the NE 1/4 corner of the Section 24 Township 2 North, Range 10 East, Fourth Principal Meridian, as described hereon; and that from this evidence I established a new monument and accessories as described hereon to perpetuate the original location of this corner.

Resident witnesses:

Mr. J. J. ...

Mr. ...

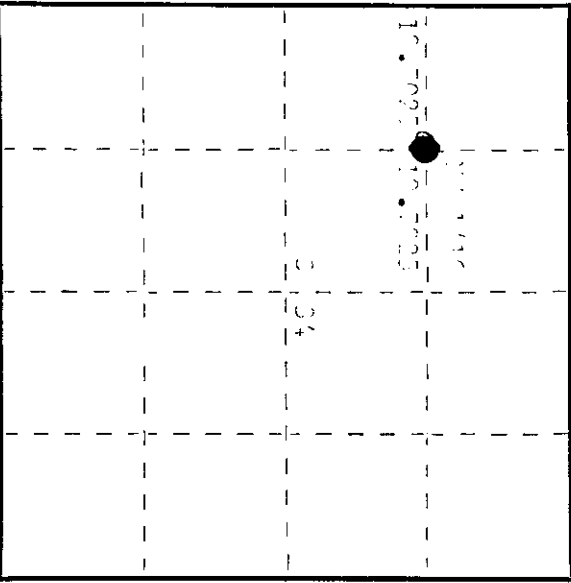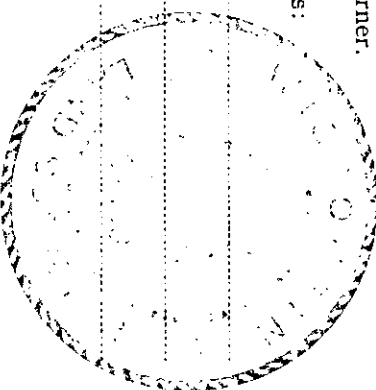

○ = Corner monument restored.

History of original corner establishment:


Description of corner evidence found:


Description of monument and accessories I established to perpetuate the original location of this corner.


Dated at Oneida, Wis., this 3rd day of October, 1977.

Signature Philip T. Starnam Title Registered Land Surveyor Registration No. 10000
(County Surveyor, Registered Land Surveyor, or other duly authorized official)

Office of Register of Deeds, County of Oneida. I hereby certify that the within instrument was filed in this office for record on the 12th day of December, 1977 at 11:00 o'clock A. M.

David George Tucker
(Register of Deeds)

By Joseph M. Berner Deputy