CERTIFIED LAND CORNER RESTORATION

Index No. A-1

State of Wisconsin
County of Oneida } ss.

I Philip T. Hansen, do hereby certify that on the 8th day of September, 1976, I found evidence of the Section corner of Sec. 36-31, 1 and 6 Township 37-38, North, Range 10 & 11, Fourth Principal Meridian, as described hereon; and that from this evidence I established a new monument and accessories as described hereon to perpetuate the original location of this corner.

Resident witnesses:

Glen Barker

Jim Claflin

Herb Wagener

WISCONSIN PHILIP T. HANSEN S-498 LAND SURVEYOR

T37N R11E

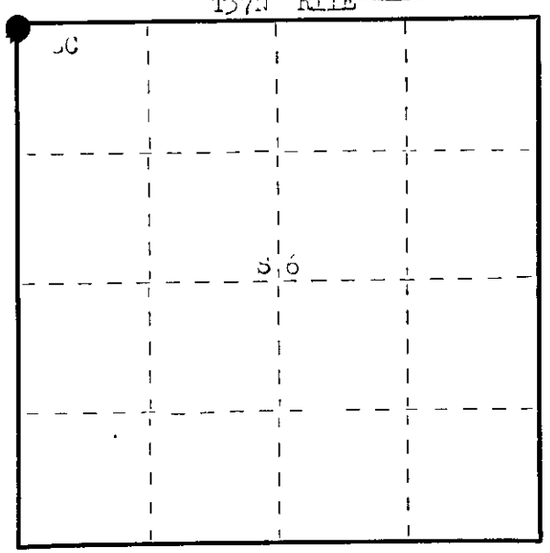

○ = Corner monument restored.

History of original corner establishment: Original corner established by Hiram C. Fellows, Deputy Surveyor, in 1859, from which Sugar 14" bears S 42° W 13 links, Hemlock 25" bears N 11° W 32 links, Sugar 8" bears N 41° W 40 links, Sugar 25" bears S 30° E 13 links.

Corner recovered by D.H. Vaughan, County Surveyor, in 1915. Set post and marked BT - Hemlock 30" S 86° W 48 links, Hemlock 18" S 23° W 31½ links.

Corner recovered by V.A. Laine, County Surveyor, in 1935. Marked BTs - Basswood 18" N 5° W 32½ links, Balsam 14" W 61° E 27 links, Hemlock 20" S 13° E 56 links. Set iron pipe.

Corner recovered by H.C. Lawrence, Registered Land Surveyor, in 1958.

Description of corner evidence found:

Recovered Laine's 2¼" iron pipe with brass cap stamped.
Monument projects 18" above ground, in excellent condition.
Unable to find any remains of Vaughan's post.
Recovered BTs - Hemlock 30" (34") S 86° W (S 84° W) 48 links,
Scribing visible (now dead)
Basswood 18" (28") N 5° W 32.5 links (37.5 lks)
Hemlock 20" (24") S 13° E 56 links, scribe marks
BT visible, now dead.
Balsam 14" W 61° E 27 links, now down & decayed.

T38N
R 10 | 26 | 31 | R 11
| 1 | 36
T37

Description of monument and accessories I established to perpetuate the original location of this corner.

As Laine's pipe was found in excellent condition, it was left in place.
BTs - Sugar 6" S 72° E 57.5 links, scribed SC BT.
Sugar 8" S 7° W 27.7 links, scribed SC BT.
Sugar 9" N 47° W 56 links, scribed SC BT.
Monument and BTs painted blue.

Dated at Rhinelander, Wis., this 20th day of September, 1976.

Signature Philip T. Hansen Title Registered Land Surveyor Registration No. S-498
(County Surveyor, Registered Land Surveyor, or other duly authorized official)

Office of Register of Deeds, County of Oneida, I hereby certify that the within instrument was filed in this office for record on the 9th day of November, 1976 at 1:30 o'clock P. M.

Doris Verage Kuehn
(Register of Deeds)

By ..... Deputy

FORM 985 H. C. MILLER CO., MILWAUKEE

581036000