

U.S. PUBLIC LAND SURVEY MONUMENT RECORD

Index No. D-E 25

State of Wisconsin

County of Oneida } ss.

I, John H. Fisher, do hereby certify that on the 22 day of October, 1984, I found evidence of the Meander corner of Section 1 & 6 Township 38 North, Range 11 & 12 E., Fourth Principal Meridian, as described hereon; and that from this evidence I established a new monument and accessories as described hereon to perpetuate the original location of this corner.

Resident witnesses:

None

History of original corner establishment: Original Survey by Alfred Willard. Dependent Resurvey in 1937 by Wesson Cook At 4.52 chains set concrete monument 24 inches long, 6 inches diameter, 22 inches in ground with brass tablet stamped: From which the following bear:

R 11 E	R 12 E	White Pine	24"	N10-1/2°E	40 lbs
$\begin{array}{r} S156 \\ \hline T30N \\ M.C. \\ 1937 \end{array}$					

Description of corner evidence found:

B.L.M. Corner as described and in place

Description of monument and accessories I established to perpetuate the original location of this corner. Corner in good condition: Blazed and scribed the following new bearing trees: Set nails in:

White Pine	6"	N14°W	6.3 feet
Red Pine	6"	N12°E	25.6 feet
White Pine	4"	N86°E	17.4 feet
Set steel sign post		South	.7 feet


Dated at Mirogqua, Wis., this 21st day of March, 1985.

Signature: *John H. Fisher* Title: Registered Land Surveyor Registration No. 8-836  
(County Surveyor, Registered Land Surveyor, or other duly authorized official)

Office of Register of Deeds, County of Oneida, I hereby certify that the within instrument was filed in this office for record on the 23rd day of October, 1985 at 3:30 p.m. M. *[Signature]*

*[Signature]*  
(Register of Deeds)

○ = Corner monument restored.

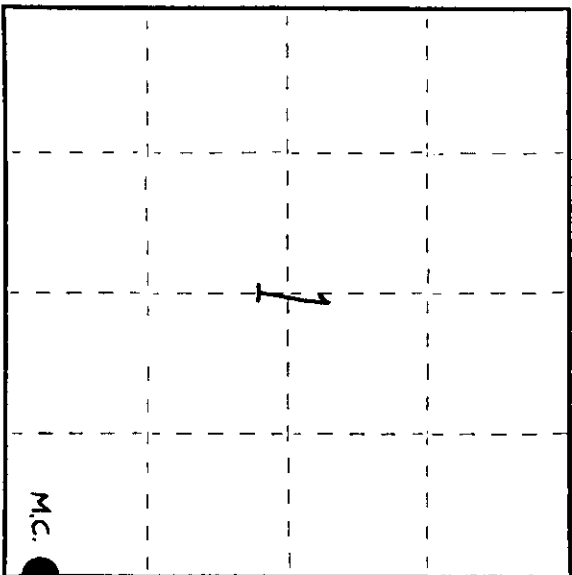

Stock No. 26273

