


This form is intended to fulfill the requirements of Chapter A-E7.08 (3)(a) thru (l) U.S. Public Land Survey Monument Location Record, Wisconsin Administrative Code. Use the reverse side of form for continuation.

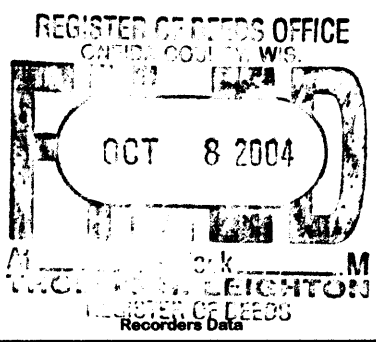


U.S. PUBLIC LAND SURVEY MONUMENT LOCATION RECORD

USPLS CORNER: EAST WITNESS MC SECTION: 11 TOWNSHIP: 38 NORTH RANGE: 11 EAST
 NAME OF WATERWAY FOR M.C. CORNER: BIG STONE LAKE SECTION LINE: NORTH
 (CITY)(VILLAGE)(TOWN) OF: THREE LAKES COUNTY OF: ONEIDA

Description of monument found or placed and all other evidence used as the basis for monument location; including monuments and measurements required if the corner location was reestablished by lost corner proportionate methods. Also indicate name of the original surveyor, original survey date and the corner monument, bearing trees, witness or other reference monuments established, including measured bearing and distance ties, from available survey records.

Found and accepted an old 6" square concrete monument with cast cross on top 11" above grade and an older green steel "U" channel post with standard USFS Land Survey Monument Sign bolted to top 1.2' South; also a red top white poly marker stake with Soder Surveying decals affixed 0.7' East of corner monument. I chiseled cast cross off top of monument and epoxied a standard stamped 3.5" dia. Oneida County aluminum tablet to the top center of monument for centering and identity purposes. Corner falls S10°E about 20 feet from an irregular boggy lake shoreline bearing S75°W/N50°E and also falls on the North edge of a foot path bearing S80°E/S60°W. This corner previously located by GPS control survey per Oneida County survey records at UTM: 337496 dE/5073620 dN. In September 1859, William E. Daugherty/GLO did not set an MC as the entire North line of Section 11 was on upland as Big Stone Lake was impounded later by the damming of Eagle River. During a 1941 GLO Resurvey, Hugh B. Crawford notes a 6" square concrete monument at this Witness MC at 537' East of the NW corner of Section 11, now in lake, per Big Stone Plat, but noted no BTs. In July 1973, Robert Bandow/RLS 104 noted a concrete monument at this Witness MC per plat of survey filed as B-757 in Oneida County survey records. On a Public Land Survey Monument Record filed April 3, 1985 in Oneida County records, John Fisher/RLS 836 noted a 6" square concrete monument at this Witness MC and new BTs: a 16" Pw S24°W 41.4', now a 15' tall dead 16" with blazes open & scribed; a 17" Pr S18E 19.0', now wind tipped 45° East; a 16" Pr N70°E 24.0', found OK and used for new ties below and a 7" Spruce N47°W 5.4', found OK and used for new ties below. In October 1998, Kip Soder/RLS 1731 noted a 6"x6" concrete monument at this Witness MC per plat of survey filed as B-4085 in Oneida County survey records. This corner recovery completed August 4, 2004; there were no direct witnesses.

Plan view map of monument location with bearing and distance ties to a minimum of four(4) described witness or reference monuments of concrete, natural stone, iron, live bearing trees or equivalent material. If applicable, also show a minimum of two(2) bearing and distance ties to any other monument found and not accepted; including the bearing and distance from the accepted monument.

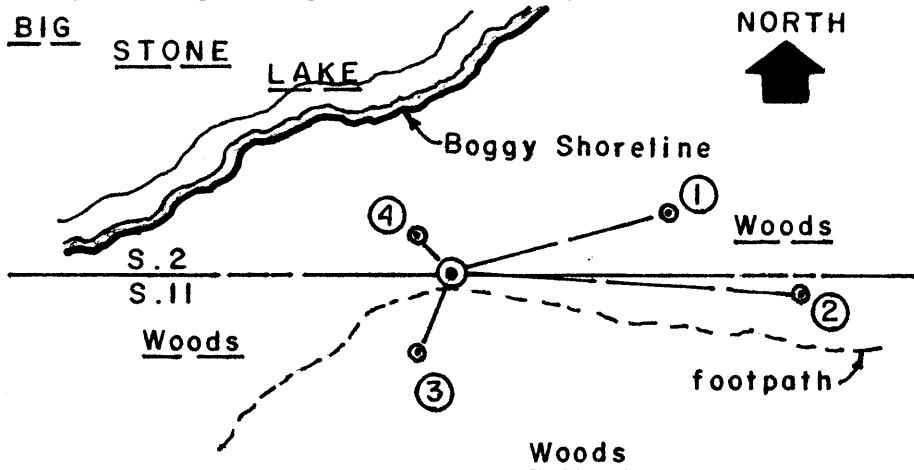

- WITNESS MONUMENT TIES:**
- ① Old 15" Pr BT N74°E 23.51' with upper blaze shut but plain, lower blaze open and a USFS BT sign on upper face.
 - ② New 14" Pw BT S86°E 36.31'.
 - ③ New 6" Pw BT S24°W 9.05'.
 - ④ Old 8" Spruce BT N46°W 5.32' with upper & lower blazes open & scribed and a USFS BT sign on upper face.
- I painted old BT blazes and flagged new BTs, monument and sign post blaze orange.

SCALE: 1" = 20'

Unless otherwise indicated, all bearing tree ties are to a .25" dia. by 2.5" long PK nail with a 1.25" dia. steel washer driven into unblazed right face and a .25" dia. by 2.5" long PK nail with a 2" dia. steel washer stamped BT is also driven into unblazed face of bearing tree at DBH; the basis for measured bearings is by compass to nearest degree and all tie distances are measured horizontal by steel tape corrected to nearest 1/100th feet at standard temperature of 68° F.


RLS SEAL:



LAND SURVEYOR CERTIFICATE:

I, William C. Rohde, hereby certify that I am duly licensed as a Professional Land Surveyor in the State of Wisconsin; that this USPLS monument location was determined by me and/or under my direct supervision and control; and that this U.S. Public Land Survey Monument Location Record is true and correct to the best of my knowledge and belief.

Signed *William C. Rohde*
 William C. Rohde RLS 841

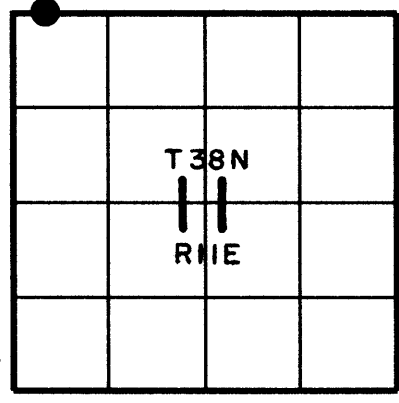

SECTION LOCATION MAP INDEX NO. E 17-18

3811, 020037