

U.S. PUBLIC LAND SURVEY MONUMENT RECORD

Index No. E 17

State of Wisconsin }
 County of Oneida } ss.

I, John H. Fisher, do hereby certify that on the 4 day of June, 1984, I found evidence of the witness corner of Sections 2, 3, 10 and 11 Township 38, North, Range 11 East, Fourth Principal Meridian, as described hereon; and that from this evidence I established a new monument and accessories as described hereon to perpetuate the original location of this corner.

Resident witnesses:

None

History of original corner establishment: Original survey in 1859 by Alfred Millard. Dependent Resurvey in 1941 by Hugh B. Crawford. At 37.40 chains set a concrete monument witness Corner 24 inches long, 6 inches diameter, 20 inches in the ground with iron post 23 inches long, 1 inch diameter embedded in center with brass tablet stamped.

From which the following bear:

<u>W. C.</u>				
<u>T 30 N R 11 E</u>	Cedar	10"	N69-1/4°E	74 lks
	Hemlock	16"	S35-1/4°E	59 lks
<u>S 3 S 2</u>	White Birch	10"	S39°W	34 lks
<u>S 10 S 11</u>	White Pine	16"	N80-1/2°W	164 lks
<u>1941</u>				

Description of corner evidence found:

B.L.M. Monument as described and in place and the following bearing trees:

Cedar	12"	N69°E	48.5 feet
Hemlock	18"	S37°E	39.0 feet

Also found 6" X 6" concrete monument on East shore of Big Stone Lake S86°55'07"E, 537.00 feet on Section line from proportioned Southwest corner of Section 2.

Description of monument and accessories I established to perpetuate the original location of this corner.

B.L.M. Corner in good condition. Also 6" X 6" concrete monument in good condition
 Set Nails in: Set nails in:

Maple	10"	S70°E	27.7 feet	White Pine	16"	S24°W	41.4 feet
Maple	5"	S38°E	11.0 feet	Red Pine	17"	S18°E	19.0 feet
Set steel sign post				Red Pine	16"	N70°E	24.0 feet
		N 6°W	1.3 feet	Spruce	7"	N47°W	5.4 feet
				Set steel sign post		South	1.2 feet


Dated at Minocqua, Wis., this 21st day of March, 1985.

Signature John H. Fisher Title Registered Land Surveyor Registration No. S-836
 (County Surveyor, Registered Land Surveyor, or other duly authorized official)

Office of Register of Deeds, County of Oneida I hereby certify that the within instrument was filed in this office for record on the 3 day of April, 1985 at 3:30 o'clock P. M.

Doris Verge Kuehn
 (Register of Deeds)

By _____ Deputy

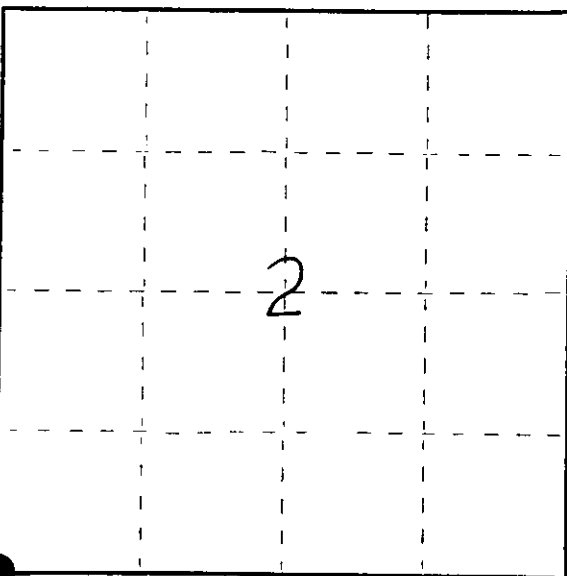

○ = Corner monument restored.

FORM NO. 985-A

U.S. G.P.O. 1975 O-272-722

Stock No. 26273

3811030000

