U.S. PUBLIC LAND SURVEY MONUMENT RECORD

Note: This form is intended and designed to fulfill all requirements of Wisconsin Administrative Code, Chapter A-E 5.02, U.S. Public Land Survey Monument Record (3) (a) (b) (c) (d) (e) (f) (g) (h) (i). An additional sheet may be added if necessary to conform with said requirements.

(a) Corner location: Township 38 North

Range 11 East/~~West~~

Town/~~City/Village~~ Three Lakes

County Oneida

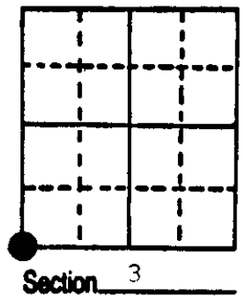

(b) (f) (g) (h) Description of monument found at this corner and if it was accepted, state all evidence (material, testimonial, occupational, plats, records, other monuments) used as a basis for accepting. If not accepted or if nothing was found, state evidence used as basis for establishing location. If reestablished through lost corner proportionate methods, indicate all monuments, distances and directions used to establish.

-1859 William E. Dougherty, North between 9 and 10 80.00 ch. Lake, set corner. Hemlock 12" S 70°E 5 lks. Hemlock 15" S 86 W 20 lks.

-1953 G.L.O. Set 2½" iron pipe with brass cap in place of 3" iron pipe with brass cap marked Oneida County Survey, reset County post North and along side Maple 4" N 48°E 27½ lks. Maple 10" S 24½° E 113 lks. Birch 6" S 36½ W 93½ lks. Birch 7" N 15°W 18 lks.

-1987 Jim Will at Corner.

-1991 William Bandow at corner witnessed as shown below: W. Post East .50'

(c) (d) (e) Plan view of corner with ties to at least 4 witness monuments. If in disagreement with previously established corner, show the distances between the two corners and also indicate the ties to the disputed corner.

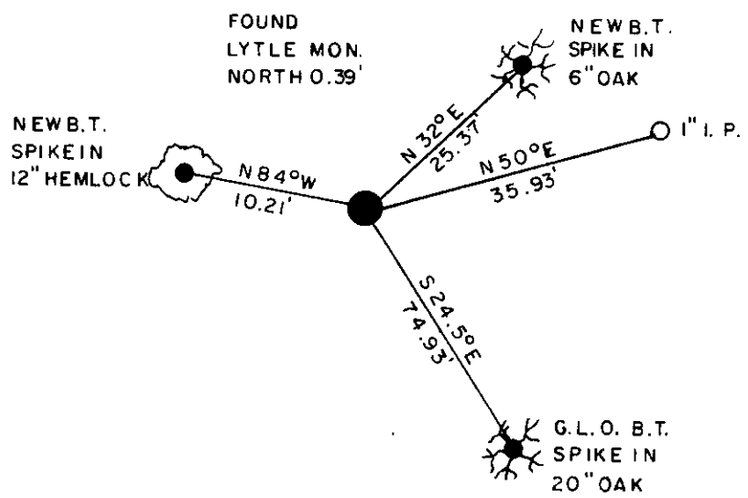

— Magnetic Bearings Taken With Handheld Compass

— Distance to 6" Nail in Side of tree

— No Scale

N

REGISTER OF DEEDS OFFICE
ONEIDA COUNTY, WIS
RECEIVED
DEC 13 1991
At _____ O'Clock _____ M
THOMAS H. LEIGHTON
REGISTER OF DEEDS

(i) I, William E. Bandow
(type or print name) certify that the corner location on this record was determined by me or under my direction and control and that this U.S. Public Land Survey Monument Record is correct and complete to the best of my knowledge and belief.

William E. Bandow 12-10-91

Signature Date

GENISOT & ASSOCIATES INC.
1512 EAGLE ST., RHINELANDER, WIS.

WISCONSIN
WILLIAM E. BANDOW
S-11
RHINELANDER
WIS.
LAND S

Index No. E-13

3811040000