

State of Wisconsin

County of Oneida } ss.

I, Robert E. Badow, do hereby certify that on the 17th day of April, 1984, I found evidence of the East one-quarter corner of Section 4, Township 38 North, Range 11 East, Fourth Principal Meridian, as described hereon; and that from this evidence I established a new monument and accessories as described hereon to perpetuate the original location of this corner.

Resident witnesses:

Michael E. Weber

Kip W. Soder

Eric Zyhowski

CERTIFIED LAND CORNER RESTORATION
U.S. PUBLIC LAND SURVEY MONUMENT RECORD
History of original corner establishment:

Index No. C-13

Original corner was established in the course of the subdivision of T 38 N, R 11 E which was started and completed in September of 1859, by William E. Daugherty, Deputy Surveyor.

Original B.T.'s:
6" Sugar N 80° W 14 lks.
7" Sugar S 40° E 14 lks.

Description of corner evidence found:

Found 1" dia. iron pipe commonly used and accepted as the East 1/4 Corner by other Surveyors.

Description of monument and accessories I established to perpetuate the original location of this corner:
Set 2 1/2" x 30" magnetic aluminum capped Oneida County monument in re-
placement of 1" iron pipe.

Blazed and scribed with nail in side the following new bearing trees:
19" Maple S 69° W 23.57 feet.
7" Maple N 56° W 28.45 feet.
14" Maple N 9° W 19.66 feet.
8" Power Pole #3811-3W25 S 88° E 3.97 feet.

Made and set wood post Northeast of corner.


Dated at Eagle River, Wis., this 17th day of April, 1984.

Signature: *Robert E. Badow* Title: Vilas County Surveyor Registration No. S-104
(County Surveyor, Registered Land Surveyor, or other duly authorized official)

Office of Register of Deeds, County of Oneida
Instrument was filed in this office for record on the 12th day of June, 1986
at 8:00 o'clock P.M. I hereby certify that the within

Donald D. Henderson
(Register of Deeds)

By *Supriya Q. Puro* Deputy

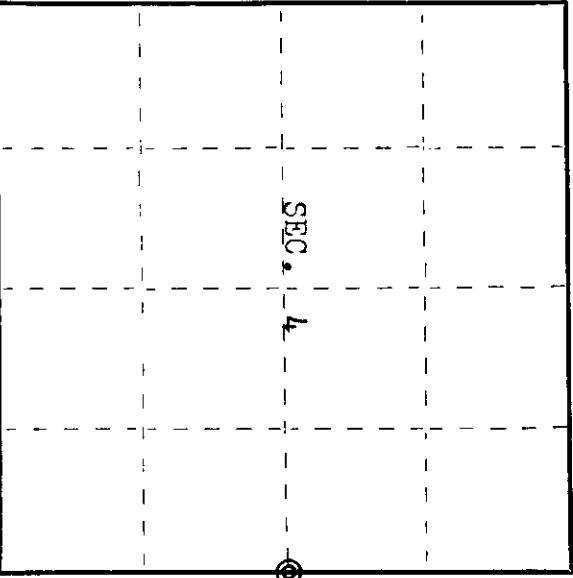

○ = Corner monument restored.

3811042000

