



Stock No. 26273

U.S. PUBLIC LAND SURVEY MONUMENT RECORD

Index No. M-N-22-23

State of Wisconsin

County of Oneida } ss.

I, JAMES R. GROTHMAN, do hereby certify that on the 13th day of October, 1986, I found evidence of the Angle Point 1 Meander corner of Section 13, Township 38 North, Range 11 East, Fourth Principal Meridian, as described hereon; and that from this evidence I established a new monument and accessories as described hereon to perpetuate the original location of this corner.

Resident witnesses:

None

History of original corner establishment: Original survey in 1859 by William E. Daugherty.

Establishment of recorded original meander line of Elm Lake in Section 13 as a fixed and limiting boundary in 1943 by Hugh B. Crawford. Set a concrete monument 2 feet long, 4 inch diameter, 20 inches in the ground with an iron post 22 inches long, 1 inch diameter, embedded in the center with brass cap marked: T38N

R11E AP1 From which the following bear:
S13 Maple 11" N47°E 94 lks
1943 Maple 16" S50°E 247 lks

Description of corner evidence found:

G.L.O. Monument as described in place. The following bearing tree:


Maple Stump 11" N47°E (Decayed)

Description of monument and accessories I established to perpetuate the original location of this corner.

Corner in good condition. Blazed, scribed, painted, and posted the following new bearing trees:

Ash 8" N53°E 50.48 feet
White Pine 8" S60°W 24.03 feet
White Pine 24" N62°W 10.51 feet
Steel Sign Post Northeastly 1.00 foot+

SECTION 13

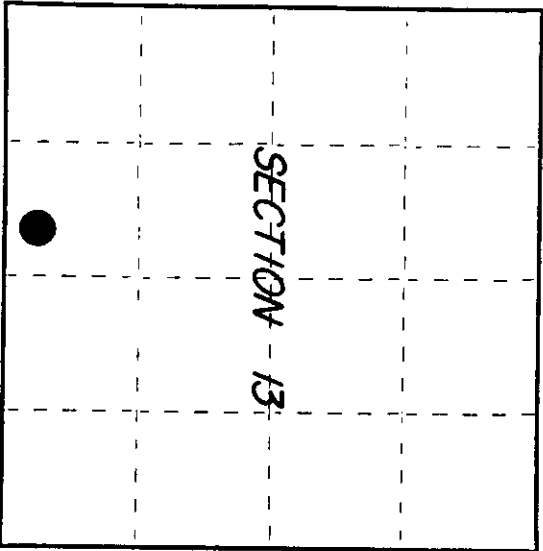

○ = Corner monument restored.


Signature [Signature] Title ELS Registration No. 1321
(County Surveyor, Registered Land Surveyor, or other duly authorized official)


(Register of Deeds)

By [Signature] Deputy

3811130223




(e) Describe any material discrepancy between the location of the corner as restored or reestablished and the location of that corner as previously restored or reestablished by distance and direction. Show the discrepancy on the plan view drawing under (d), above. Show the distances between the corner as previously restored or reestablished and (1) the corner as restored or reestablished, and (2) to at least 2 of the witness monuments shown on the drawing in (d), above.

See drawing below

(f) Was the corner restored through acceptance of (1) an obliterated evidence location, or, (2) a found perpetuated location?

Corner was restored through acceptance of a found perpetuated location.

(g&h) Was the corner reestablished through lost corner proportionate methods? If so, show the method, including the directions and distances to other public land survey corners used as evidence or used for proportioning in determining the corner location?

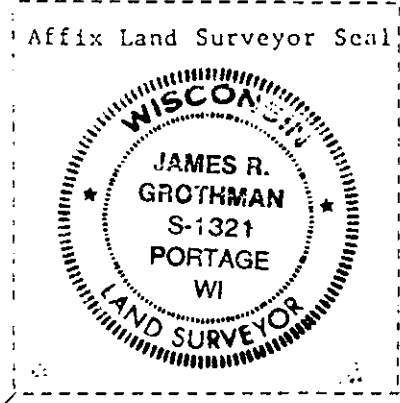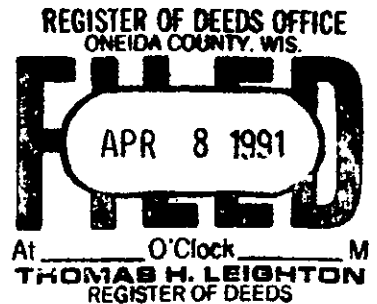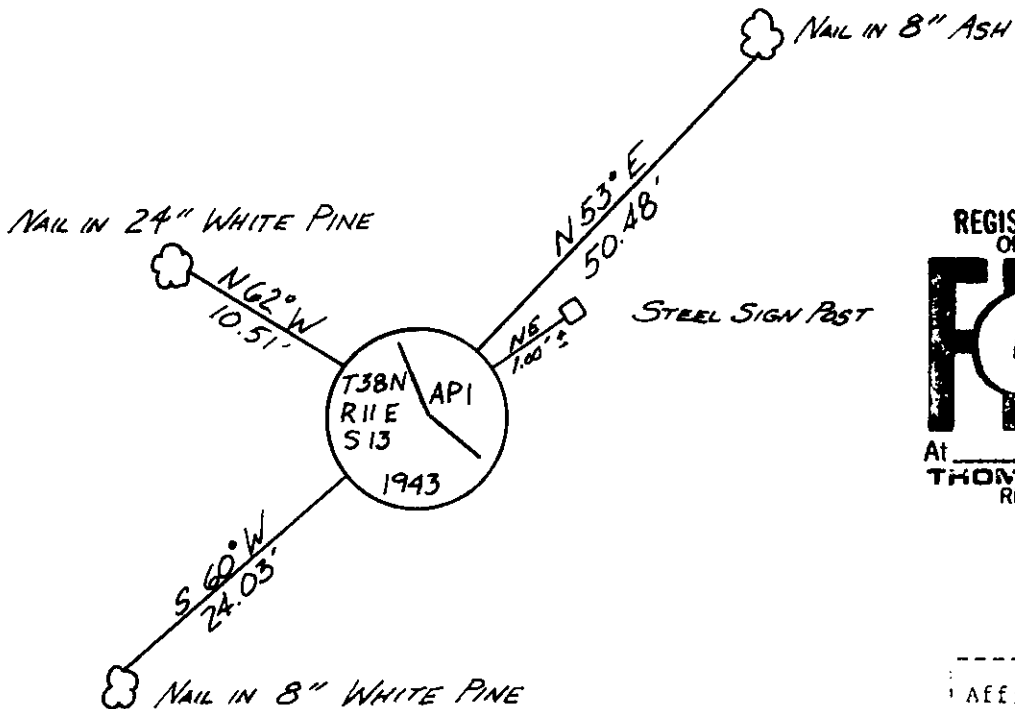

(1) JAMES R. GROTHMAN, Registered Land Surveyor No. 1321 (type or print name) certify that the corner location shown on this record was determined by me or under my direction and control and that this U.S. Public Land Survey Monument Record is correct and complete to the best of my knowledge and belief.

James R. Grothman 16/30/86
Signature Date

Certificate ready for filing: N. Seanda Houlby 1/6/87
District Ranger Date