



Stock No. 26273

U.S. PUBLIC LAND SURVEY MONUMENT RECORD

Index No. M-N-21-22

State of Wisconsin

County of Oneida } ss.

I, JAMES R. GROTHMAN, do hereby certify that on the 13th day of October, 1986, I found evidence of the Angle Point 3 Meander corner of Section 13, Township 38 North, Range 11 East, Fourth Principal Meridian, as described hereon; and that from this evidence I established a new monument and accessories as described hereon to perpetuate the original location of this corner.

Resident witnesses:

None

History of original corner establishment. Original survey in 1859 by William E. Daugherty.

Establishment of recorded original meander line of Elm Lake in Section 13 as a fixed and limiting boundary in 1943 by Hugh B. Crawford. Set a concrete monument 2 feet long, 4 inch diameter, 18 inches in the ground with an iron post 22 inches long 1 inch diameter embedded in the center with brass cap marked: T38N

R11E AP3 From which the following bear: Maple 14" S48°E 189 lks  
S13 S13 Elm 14" N21°W 238 lks  
1943

Description of corner evidence found:


G.L.O. monument as described in place. Found the following bearing tree:

Maple stump S48°E (Decayed)

Description of monument and accessories I established to perpetuate the original location of this corner.

Corner in good condition. Blazed, scribed, painted, and posted the following new bearing trees:

Maple 14" S54°E 117.37 feet  
Hemlock 5" N75°W 50.41 feet  
Steel Sign Post East

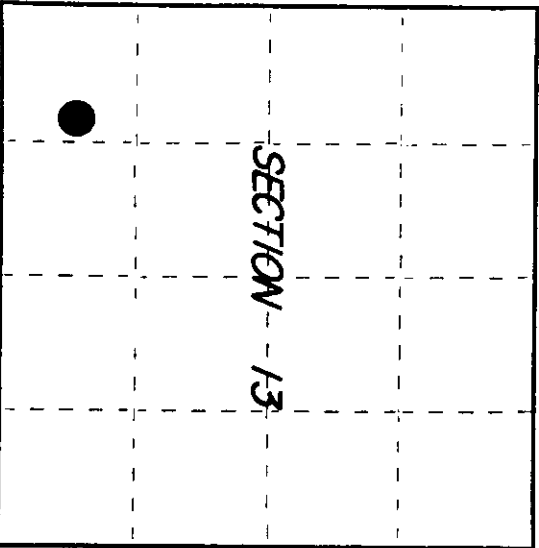

○ = Corner monument restored.

Dated at Portage Wis., this 30 day of October, 1986

Signature James R. Grothman Title RLS (County Surveyor, Registered Land Surveyor, or other duly authorized official) Registration No. 1321

Office of Register of Deeds, County of Oneida, I hereby certify that the within instrument was filed in this office for record on the 19th day of October, 1986 at 10:00 o'clock M.

(Register of Deeds)

By Deputy

381130632




(e) Describe any material discrepancy between the location of the corner as restored or reestablished and the location of that corner as previously restored or reestablished by distance and direction. Show the discrepancy on the plan view drawing under (d), above. Show the distances between the corner as previously restored or reestablished and (1) the corner as restored or reestablished, and (2) to at least 2 of the witness monuments shown on the drawing in (d), above.

See drawing below

(f) Was the corner restored through acceptance of (1) an obliterated evidence location, or, (2) a found perpetuated location?

Corner was restored through acceptance of found perpetuated location.

(g&h) Was the corner reestablished through lost corner proportionate methods? If so, show the method, including the directions and distances to other public land survey corners used as evidence or used for proportioning in determining the corner location?

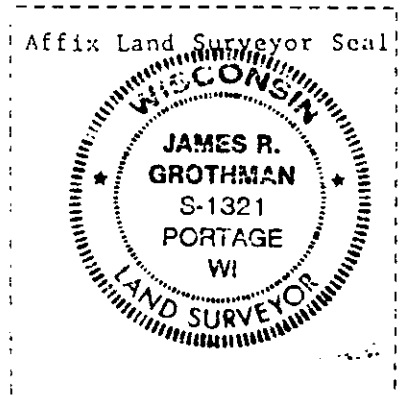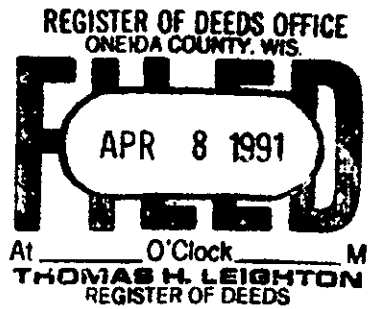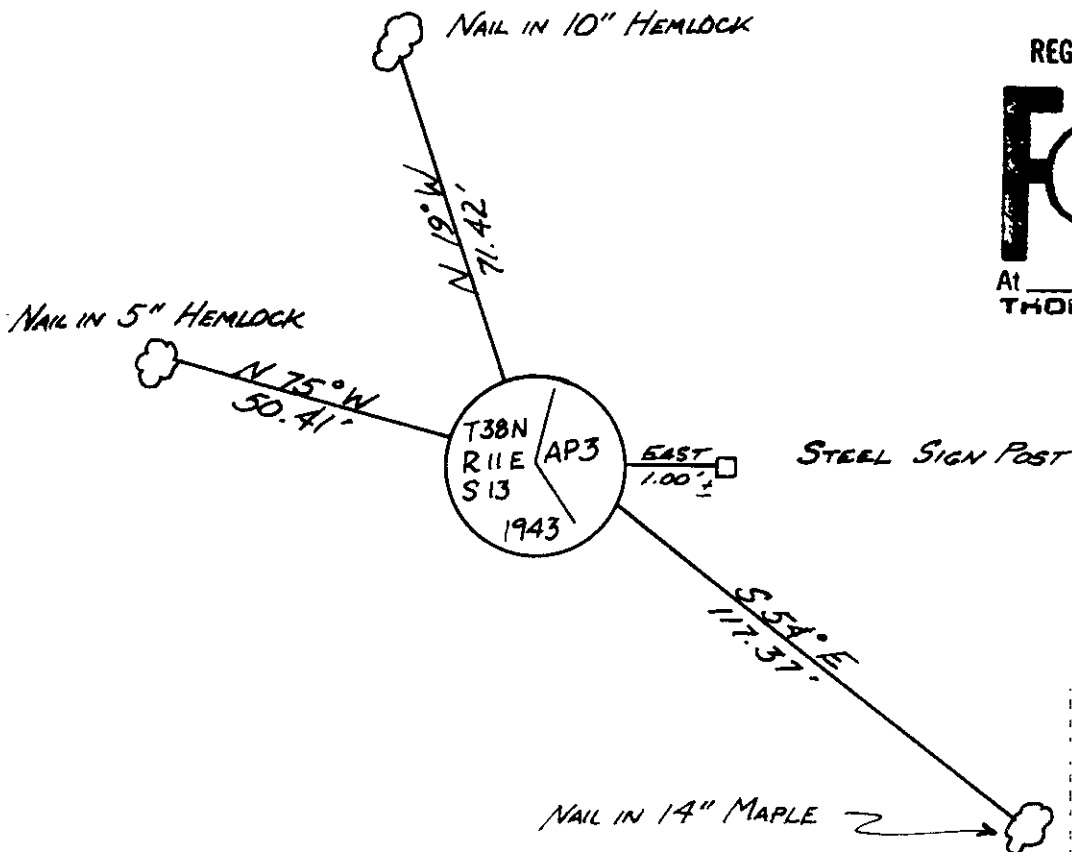

(i) I, JAMES R. GROTHMAN, Registered Land Surveyor No. 1321 [type or print name] certify that the corner location shown on this record was determined by me or under my direction and control and that this U.S. Public Land Survey Monument Record is correct and complete to the best of my knowledge and belief.

*James R. Grothman* 10/30/86  
 Signature Date

Certificate ready for filing: *M. Frank Haulby* 1/4/87  
 District Ranger Date