



Stock No. 26273

US PUBLIC LAND SURVEY MONUMENT RECORD

Index No. K-L-22-23

State of Wisconsin } ss. County of Oneida

I JAMES R. GROTHMAN do hereby certify that on the 13th day of October 1986, I found evidence of the Angle Point 7 Meander corner of Section 13 North, Range 11 East, Fourth Principal Meridian, Township 38 North, Range 11 East, as described hereon; and that from this evidence I established a new monument and accessories as described hereon to perpetuate the original location of this corner.

Resident witnesses: None

History of original corner establishment: Original survey in 1859 by William E. Daugherty.

Establishment of recorded original meander line of Elm Lake in Section 13 as a fixed and limiting boundary in 1943 by Hugh B. Crawford. Set an iron post 3 feet long, 1 inch diameter, 27 inches in the ground, with brass cap marked:

T38NR11E From which the following bear: Cedar 14" S61-1/2°W 13.5 lks S13 Cedar 14" N17-1/4°W 6 lks AP7 1943

Description of corner evidence found:

G.L.O. monument as described in place. leaning S32°E. The following bearing trees: Cedar 16" S62°W 8.85 feet Cedar 8" N13°W 9.50 feet

Description of monument and accessories I established to perpetuate the original location of this corner.

Blazed, scribed, painted, and posted all found bearing trees and the following new bearing tree:

Cedar 20" S12°E 31.98 feet Steel Sign Post Southeasterly 1.00 foot±


Dated at PORTAGE Wis. this 23 day of DECEMBER 1986

Signature James R. Grothman Title ACS Registration No. 1321 (County Surveyor, Registered Land Surveyor, or other duly authorized official)

Office of Register of Deeds, County of Oneida, I hereby certify that the within instrument was filed in this office for record on the 13th day of October 1986 at 10:00 o'clock A.M.

(Register of Deeds)

By Deputy

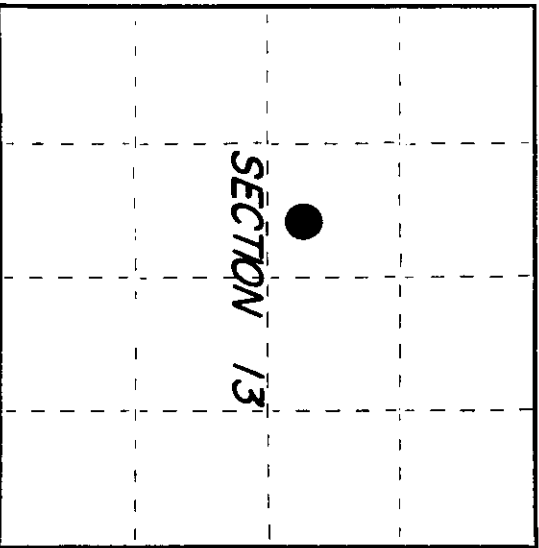

O = Corner monument restored.

281113222A


(e) Describe any material discrepancy between the location of the corner as restored or reestablished and the location of that corner as previously restored or reestablished by distance and direction. Show the discrepancy on the plan view drawing under (d), above. Show the distances between the corner as previously restored or reestablished and (1) the corner as restored or reestablished, and (2) to at least 2 of the witness monuments shown on the drawing in (d), above.

See drawing below

(f) Was the corner restored through acceptance of (1) an obliterated evidence location, or, (2) a found perpetuated location?

Corner was restored through acceptance of a found perpetuated location.

(g&h) Was the corner reestablished through lost corner proportionate methods? If so, show the method, including the directions and distances to other public land survey corners used as evidence or used for proportioning in determining the corner location?

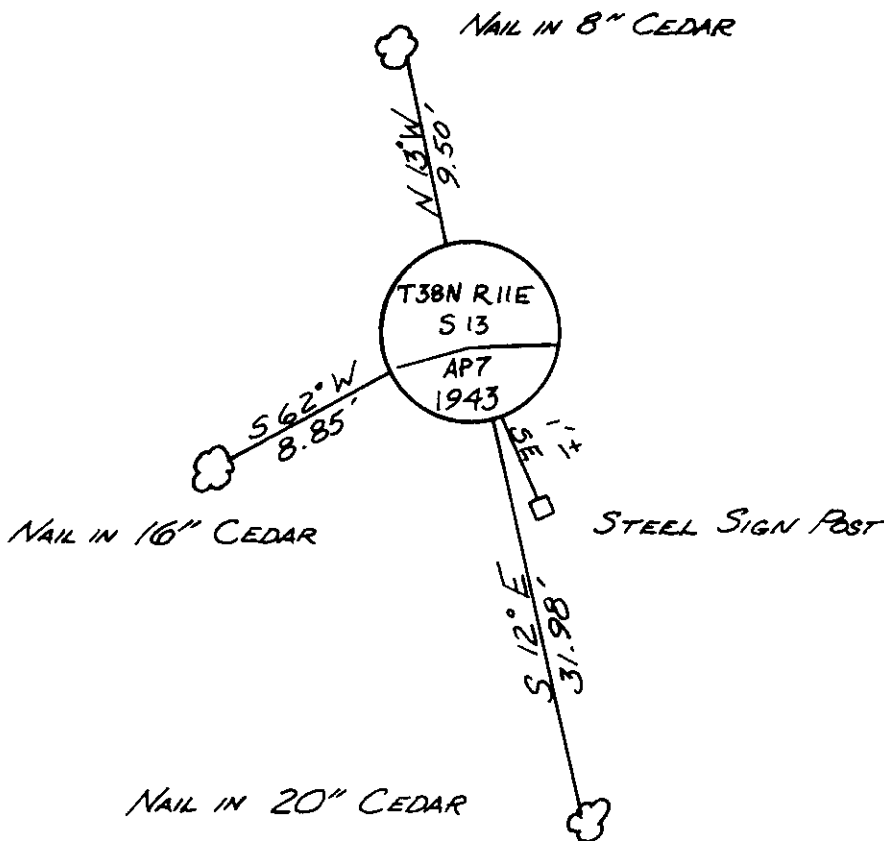

REGISTER OF DEEDS OFFICE  
ONEIDA COUNTY, WIS.  
**FILED**  
APR 8 1991  
At \_\_\_\_\_ O'Clock \_\_\_\_\_ M  
THOMAS H. LEIGHTON  
REGISTER OF DEEDS

Affix Land Surveyor Seal

(1) I, JAMES R. GROTHMAN, Registered Land Surveyor No. 1321 (type or print name; certify that the corner location shown on this record was determined by me or under my direction and control and that this U.S. Public Land Survey Monument record is correct and complete to the best of my knowledge and belief.

James R. Grothman 10/30/86  
Signature Date

Certificate ready for filing: M. Frank Haubey 1/6/87  
District Ranger Date