REGISTER OF DEEDS OFFICE
ONEIDA COUNTY
FILED

JUN 01 2017

AT_____O'CLOCK_____M
KYLE J. FRANSON
REGISTER OF DEEDS

U.S. PUBLIC LAND SURVEY MONUMENT RECORD

Note: This form is intended and designed to fulfill all requirements of the Wisconsin Administrative Code, Chapter A-E 7.08 U.S. Public Land MonumentRecord (3)(a)(b)(c)(d)(e)(f)(g)(h)(i). An additional sheet may be added if necessary to conform with said requirements.

(a) CORNER LOCATION:
North M. C. east line of Section 17
Township 38 North
Range 11 East
Town of Three Lakes
County of Oneida

WISCRS - Oneida County
North: 216114.919 USft
East: 335056.389 USft
Latitude: 45°46' 40.83440" N
Longitude: 89° 07' 57.86931" W
Datum: NAD 83(2011)
GNSS Method: RTK - Direct
GNSS Control: WISCORS VRS
Record North: 216114.959 USft
Record East: 335056.491 USft
Record Datum: NAD 83(1991)

(RECORDING AREA)

SECTION 17

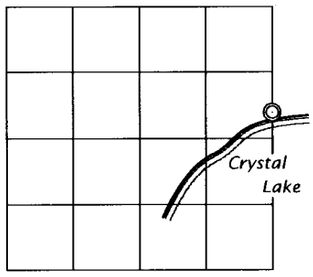

(b) HISTORY OF ORIGINAL CORNER ESTABLISHMENT
Original Surveyor: William E. Dougherty
Date of Survey: Commenced August 30, 1859
Completed September 5,1859
Original B.T.'S: Birch 10" N 5°E, 18 lks.
Birch 12" N 6°W 19 lks.

(f)(g)(h) DESCRIPTION OF MONUMENT FOUND AT THIS CORNER AND IF IT WAS ACCEPTED, STATE ALL EVIDENCE (MATERIAL, TESTIMONIAL, OCCUPATIONAL, PLATS, RECORD, OTHER MONUMENTS) USED AS A BASIS FOR ESTABLISHING LOCATION. IF NOT ACCEPTED OR IF NOTHING WAS FOUND, STATE EVIDENCE USED AS BASIS FOR ESTABLISHING LOCATION. IF REESTABLISHED THROUGH LOST CORNER PROPORTIONATE METHODS, INDICATE ALL MONUMENTS, DISTANCES AND DIRECTIONS USED TO ESTABLISH. INDICATE TYPE OF MONUMENT AND SIGN POST FOUND OR SET.

July 12, 1957 - Robert E. Bandow, RLS No. 104, Genisot Engineering Co., Dwg. No. 2025, filed in county surveyor's office as C2549, boundary map of Section 16, shows no recovered meander corners along west section line.

April 11, 1963 - Robert E. Bandow, RLS No. 104, Genisot Engineering Co., Dwg. No. 3209, last revised 7/16/81, filed in county surveyor's office as B1129, legends M.C. monumented by an iron pipe.

March 29, 2017 - James D. Rein, PLS No. 1234, we recovered a 1.5" dia. iron pipe at the notherly edge of Crystal Lake. We are unable to recover any original corner evidence. Thus, based on county published coordinate data, I determine the recovered munument is on a nearly straight line and a good faith re-establishment of the lost meander corner. We replaced the iron pipe with an Oneida County capped monument and made reference ties as shown in the plan.

The coordinate value shown has been verified by at least one of the following methods: 1) comparison to a previously GPS determined published value; 2) the value is the average of two or more GPS observations at a markedly different time; 3) one or more distances were measured back to the GPS observed corner from temporary GPS observed offset locations.

(c)(d)(e) PLAN VIEW OF CORNER WITH TIES TO AT LEAST 4 WITNESS MONUMENTS. IF IN DISAGREEMENT WITH PREVIOUSLY ESTABLISHED CORNER, SHOW THE DISTANCE BETWEEN THE TWO CORNERS AND ALSO INDICATE THE TIES TO THE DISPUTED CORNER.

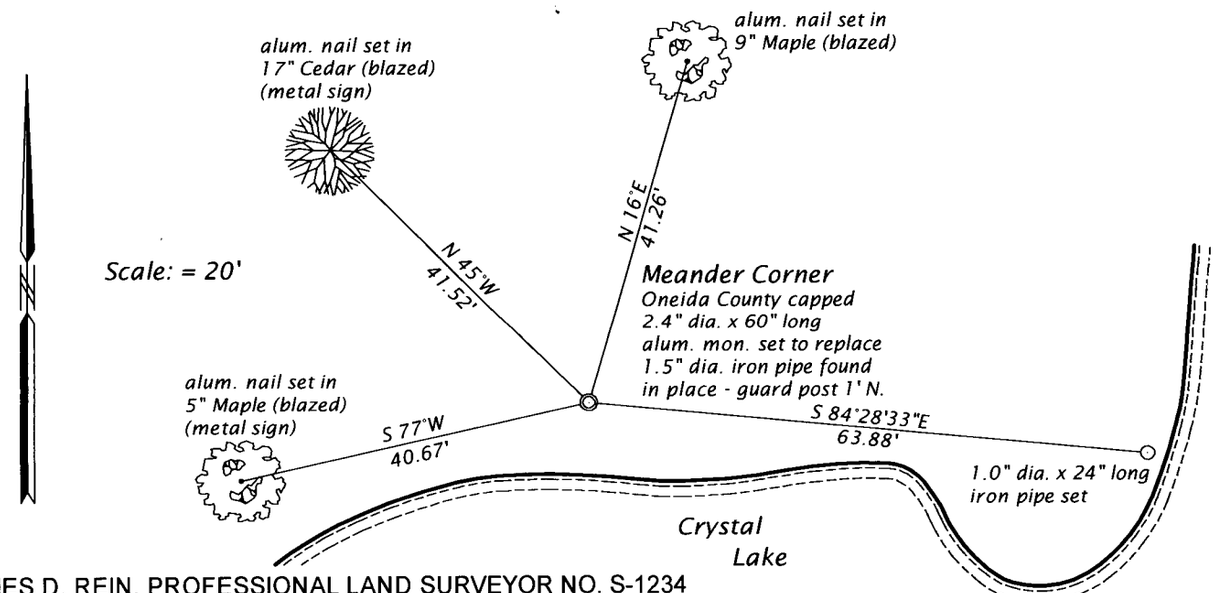

(i) I, JAMES D. REIN, PROFESSIONAL LAND SURVEYOR NO. S-1234 HEREBY CERTIFY THAT THE CORNER LOCATION ON THIS RECORD WAS DETERMINED BY ME OR UNDER MY DIRECTION AND CONTROL AND THAT THIS U.S. PUBLIC LAND SURVEY MONUMENT RECORD IS CORRECT AND COMPLETE TO THE BEST OF MY KNOWLEDGE AND BELIEF.

WISCONSIN
JAMES D. REIN
S-1234
MINOCQUA, WI
LAND SURVEYOR

5-24-17

SIGNATURE DATE

INDEX NO. KL - 9
3811172400