

CERTIFIED LAND CORNER RESTORATION

U.S. PUBLIC LAND SURVEY MONUMENT RECORD
History of original corner establishment:

Original corner was established in the course of the subdivision of T 38 N, R 11 E in September of 1859 by William E. Daugherty, Deputy Surveyor.

Original B.T.'s:
7" Maple S 62° E 24 lks.
10" Hemlock N 22° W 40 lks.

Description of corner evidence found:
Found a 1-1/4" iron pipe on a N-S fenceline.

Found the following bearing trees in place:
10" Maple West 9.86' (Measurements are to a nail in
6" W. Birch S 24° E 18.72' the side of the trees.)

Description of monument and accessories I established to perpetuate the original location of this corner.

Replaced the iron pipe with a 2 1/2"x36" Oneida County magnetic aluminum capped monument.

Made the following new bearing trees:
5" Maple N 31° E 7.03' (Measurements are to a nail in the
5" Maple S 46° W 29.01' side of the trees.)

Dated at Eagle River, Wis., this 27th day of June, 1984.

Signature: *James L. Will* Title: Registered Land Surveyor Registration No. S-14110
(County Surveyor, Registered Land Surveyor, or other duly authorized official)

Office of Register of Deeds, County of Oneida
Instrument was filed in this office for record on the 13 day of June, 1984 at 2:00 o'clock P.M. I hereby certify that the within

David V. ...
(Register of Deeds)


By: *Augustine A. ...* Deputy

State of Wisconsin }
County of Oneida } ss.

I, James L. Will, do hereby certify that on the 26th day of June, 1984, I found evidence of the East one-quarter corner of Section 28 Township 38 North, Range 11 East, Fourth Principal Meridian, as described hereon; and that from this evidence I established a new monument and accessories as described hereon to perpetuate the original location of this corner.

Resident witnesses:

Kip W. Soder

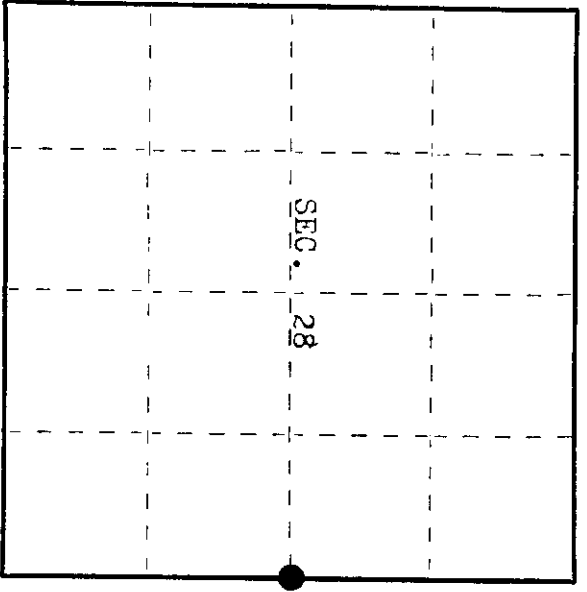

● = Corner monument restored.

(e) Describe any material discrepancy between the location of the corner as restored or reestablished and the location of that corner as previously restored or reestablished by distance and direction. Show the discrepancy on the plan view drawing under (d), above. Show the distances between the corner as previously restored or reestablished and (1) the corner as restored or reestablished, and (2) to at least 2 of the witness monuments shown on the drawing in (d), above.

None. See drawing below.

(f) Was the corner restored through acceptance of (1) an obliterated evidence location, or, (2) a found perpetuated location?

Corner was restored through acceptance of a found perpetuated location.

(g&h) Was the corner reestablished through lost corner proportionate methods? If so, show the method, including the directions and distances to other public land survey corners used as evidence or used for proportioning in determining the corner location?

