

This form is intended to fulfill the requirements of Chapter A-E 7.08 (3)(a) thru (i) U.S. Public Land Survey Monument Location Record, Wisconsin Administrative Code. Use the reverse side of form for continuation.

U.S. PUBLIC LAND SURVEY MONUMENT LOCATION RECORD

Recorders Data

USPLS CORNER: NW SECTION CORNER SECTION: 32 TOWNSHIP: 38 NORTH RANGE: 11 EAST

NAME OF WATERWAY FOR M.C. CORNER : N/A SECTION LINE: N/A

(CITY)(VILLAGE)(TOWN) OF: STARKS COUNTY OF: ONEIDA

Description of monument found or placed and all other evidence used as the basis for monument location; including monuments and related measurements required if the corner location was reestablished by lost corner proportionate methods. Also indicate name of original surveyor, original survey date and the corner monument, bearing trees, witness or other reference monuments established; including measured bearing and distance ties, from available records.

Found and accepted an older yellow painted 2" dia. iron pipe with 4" sq. steel plate cap stamped by Ripco 16" above grade and plumb at this corner location. I removed the 50" long iron pipe with soil anchor rod thru bottom end and reset a standard 2" aluminum pipe monument with cast aluminum point and stamped Oneida County cap in soil cavity to 6" above grade and secured for ties. I left the old monument flat on grade nearby. No older BTs were observed.

In September 1859, William E. Daugherty/GLO set a wood post as the original corner and marked OBTs: A 12" Sugar Maple S20°W 30 links and a 10" Sugar Maple N30°E 28 links; all of which are now obliterated.


In November 1909, D.H. Vaughan reset original corner with a 4" sq. cedar post from down and rotted SW OBT and marked a new BT 18" Pw stump N73°W 62.5 links per his notes on Page 111 in Old Field Book #6 in Oneida County survey records; post and stump are now obliterated.

In May 1941, V.M. Maine found Vaughans 1909 wood post at edge of field and further verified by Russell E. Vaughan as the original corner per notes on Page 47 in Maine 1941 Field Notes Book in Oneida County survey records.

In 1958, Norman J. Loftus/RLS 259 surveyed south and west from this corner per Ripco field notes and Plat of Survey B-3588 in Oneida County survey records; Loftus having undoubtedly set the Ripco capped iron pipe at the corner.

In 1995, Kip W. Soder /RLS 1731 found the Ripco iron pipe per Plat of Survey B-3142 in Oneida County survey records.

Plan view map of monument location with bearing and distance ties to a minimum of four(4) described witness or reference monuments of concrete, natural stone, iron, live bearing trees or equivalent material. If applicable, also show a minimum of two(2) bearing and distance ties to any other monument found and not accepted; including the bearing and distance from the accepted monument.

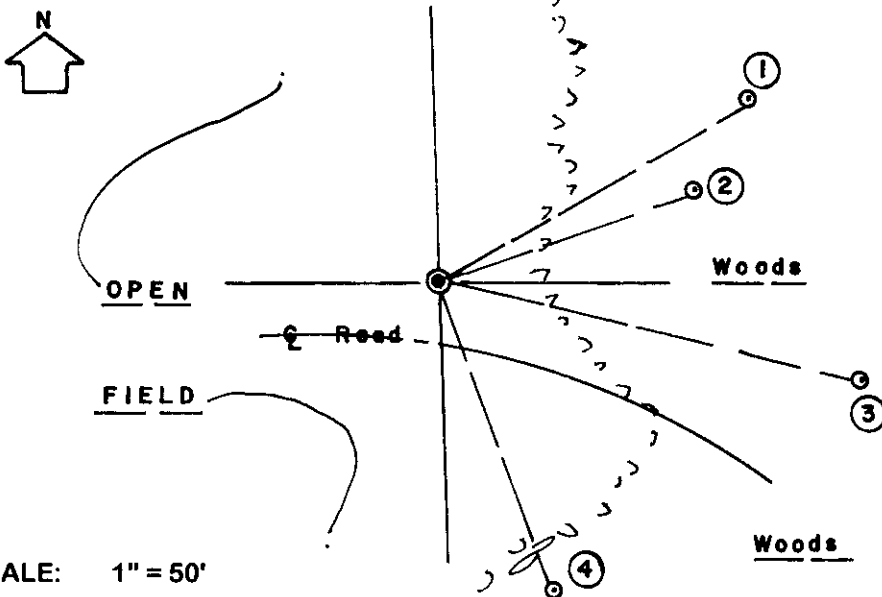

WITNESS MONUMENT TIES:

- ① - New BT 6" Pw N59°E 94.50'.
- ② - New BT 15" Pw N69°E 71.07' to PK nail & washer in left face.
- ③ - New BT 5" Pw S77°E 112.90'.
- ④ - New BT 7" Pw S21°E 94.50'.

Standard white poly 'T' marker post set 7" West of new monument.

Corner falls about 790' East of the centerline of N/S Branham Road near East edge of open field. This recovery completed June 20, 2001; there were no direct witnesses.

SCALE: 1" = 50'

Unless otherwise indicated, all bearing tree ties are to a .25" dia. by 2.5" long PK nail with a 1.25" dia. steel washer driven into unblazed right face and a .25" dia. by 2.5" long PK nail with a 2" dia. steel washer stamped BT is also driven into unblazed face of bearing tree at DBH; the basis for measured bearings is by compass to nearest degree and all tie distances are measured horizontal by steel tape corrected to nearest 1/100th feet at standard temperature of 68° F.

RLS SEAL:




LAND SURVEYOR CERTIFICATE:

I, William C. Rohde, hereby certify that I am duly licensed as a Professional Land Surveyor in the State of Wisconsin; that this USPLS monument location was determined by me and/or under my direct supervision and control; and that this U.S. Public Land Survey Monument Location Record is true and correct to the best of my knowledge and belief.

Signed *William C. Rohde*
William C. Rohde RLS 841

Date Signed: March 25, 2002

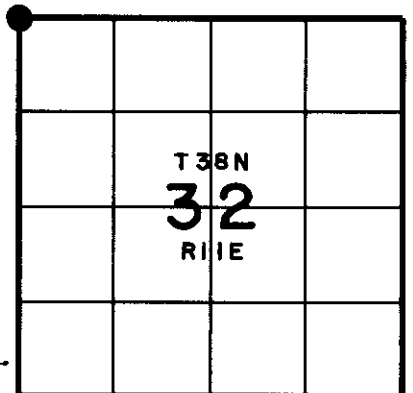

SECTION LOCATION MAP

INDEX NO. V 5