CERTIFIED LAND CORNER RESTORATION

Index No. A-2

State of Wisconsin
County of Oneida } ss.

I Philip T. Hansen, do hereby certify that on the 30th day of September, 19 76, I found evidence of the 1/16 corner of Section 6 and 31 Township 37 & 38, North, Range 11 East, Fourth Principal Meridian, as described hereon; and that from this evidence I established a new monument and accessories as described hereon to perpetuate the original location of this corner.

Resident witnesses:

Glen Barker

Jim Claflin

Herb Wagoner

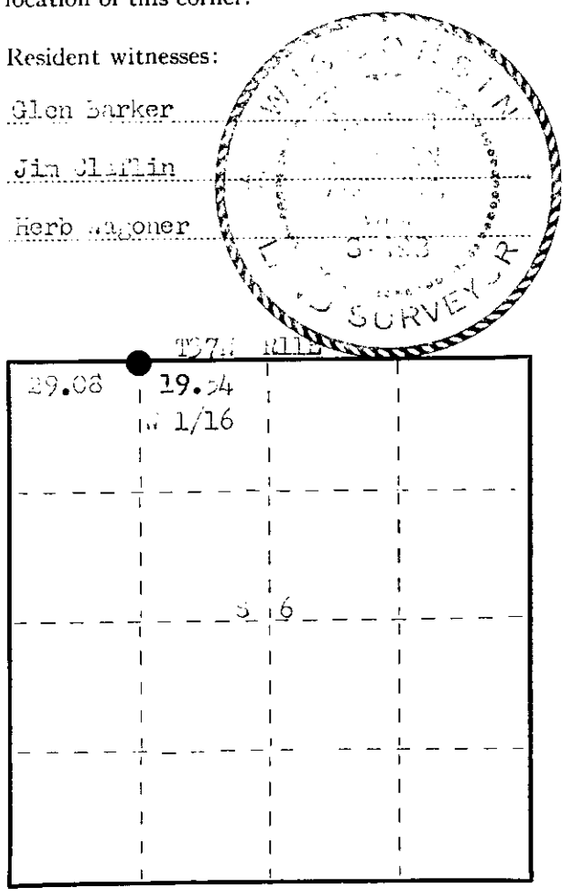

○ = Corner monument restored.

History of original corner establishment:

Corner re-established by H. Loftus in 1958. Set 1½" iron pipe for corner by proportion from township corner to recovered 1/4 corner.
This line run by H.C. Lawrence in 1958. His survey did not agree with Loftus location, found a difference of 4.72 chains too far west. Set his post at 19.54 chains west of 1/4 corner. Loftus later moved his post to coincide with Lawrence.

Description of corner evidence found:

Recovered an old 3" squared cedar stake, H.C. Lawrence's 4" squared cedar post scribed N 1/16 S6, N 1/16 S31. Also Alpco's 1½" iron pipe with 2" squared brass cap. All three corners in a radius of one link. Loftus brass cap stamped:

T38N R11E
N 1/16 S 31 / S 6
T37N R11E

Recovered Lawrence's WBT – Tamarack 12" S 57° E 43.1 links, scribed S31 N1.

Description of monument and accessories I established to perpetuate the original location of this corner.

Extracted the wood posts from the muck and set Alpco's pipe in the hole of Lawrence's post.
Drove the old posts back beside iron pipe.
Monument projects 12" above ground.
WBT – Tamarack 8" S 30° E 39.0 links, scribed 1/16 BT.
Pts and monument painted blue.

Dated at Rhinelander, Wis., this 2nd day of November, 1976.

Signature Philip T. Hansen Title Registered Land Surveyor Registration No. S-498
(County Surveyor, Registered Land Surveyor, or other duly authorized official)

Office of Register of Deeds, County of Oneida, I hereby certify that the within instrument was filed in this office for record on the 9th day of November, 19 76, at 3:00 o'clock P M.

Doris Verage Kuehn
(Register of Deeds)

By ..... Deputy

FORM 985 N. C. MILLER CO., MILWAUKEE

38113100030