

CERTIFIED LAND CORNER RESTORATION

Index No. **A-3**

State of Wisconsin

County of Oneida } ss.



I, Phillip A. Johnson, do hereby certify that on the 30th day of September, 1976, I found evidence of the corner corner of section 6 and 31 Township 37 North, Range 11 East, Fourth Principal Meridian, as described hereon; and that from this evidence I established a new monument and accessories as described hereon to perpetuate the original location of this corner.

Resident witnesses:

Glen Warner

Jim Staffin

Herb Wagner

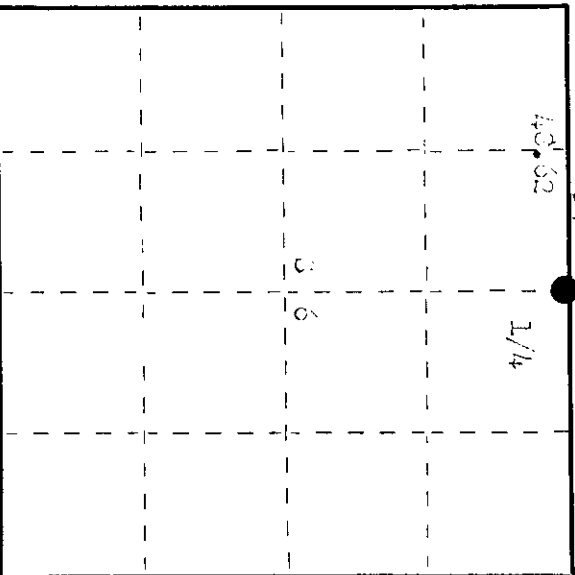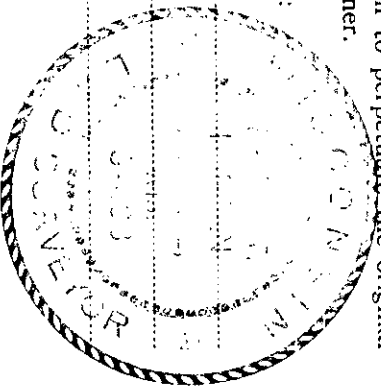

○ = Corner monument restored.

History of original corner establishment: Original corner established by William J. Fellows - Deputy surveyor in 1857 from White Pine corner 20th bears 33° E 44 links and Biron 20th bears 60° W 20 links.  
 Corner recovered by D.H. Vaughan, County Surveyor, marked WPTs - white pine 14" N 27° W 86 1/2 links, White Pine 14" N 35° W 79 1/2 links.  
 Corner recovered by W. Loftus, Algoa surveyor, recovered wood post and iron pipe, set new iron pipe with 4" squared brass cap, scribed: T38W 11E  
 monument projects 18" above ground.

Description of corner evidence found:

recovered loftus iron pipe with 4" square brass cap in good condition. Also an old squared post laying beside it.  
 recovered WPT - white pine 14" N 27° W 86 1/2 links, scribed WPT grown over.  
WPT - white pine 14" N 35° W 79 1/2 links, scribed WPT.

Description of monument and accessories I established to perpetuate the original location of this corner.  
 as the monument was in very good condition, it was left in place.

WPTs - white pine 14" N 27° W 86 1/2 links, scribed WPT.  
WPT - white pine 14" N 35° W 79 1/2 links, scribed WPT.  
 measurements and bearings to corner of old monument WPTs.

1/4  $\frac{31}{6}$  1/4  
 T37W 11E  
 11W10

3811310020

Dated at Mineral under Wis., this 28th day of November, 1976.

Signature Phillip A. Johnson Title Registered Land Surveyor Registration No. 1003  
 (County Surveyor, Registered Land Surveyor, or other duly authorized official)

Office of Register of Deeds, County of Oneida.  
 Instrument was filed in this office for record on the 9th day of December, 1976, at 1:36 o'clock P. M.

Terrie Wagner Tucker  
 (Register of Deeds)

By Terrie Wagner Tucker Deputy