

CERTIFIED LAND CORNER RESTORATION

Index No. X-5

State of Wisconsin } ss.
County of Oneida

I Phillip T. Hansen, do hereby
certify that on the 18th day
of April, 1978, I found

evidence of the Quarter
corner of Sections 31 & 32



Township 38, North, Range
11 East, Fourth Principal Meridian,

as described hereon; and that from this evidence
I established a new monument and accessories
as described hereon to perpetuate the original
location of this corner.

Resident witnesses:

Jim Claflin

John Maebaum

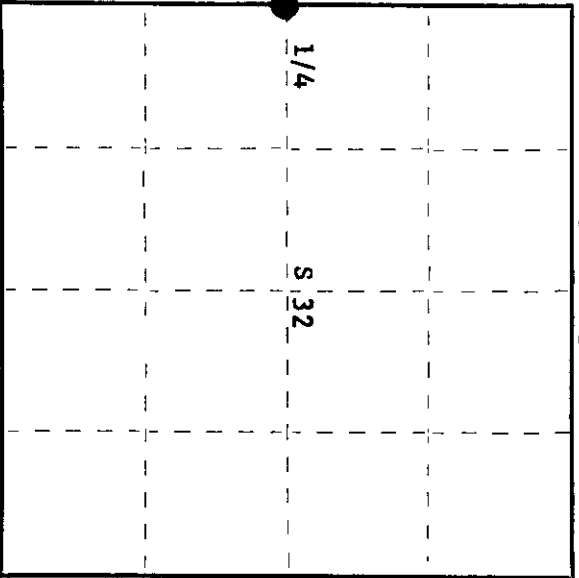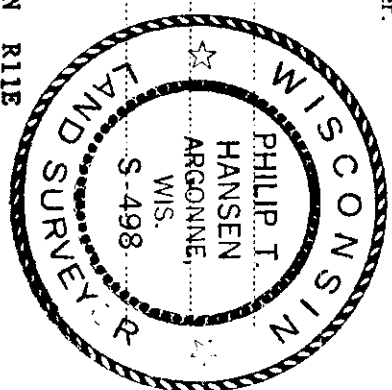

○ = Corner monument restored.

History of original corner establishment:

In 1958, N. Loftus, Ripco surveyor, found D.H. Vaughan's 1/4 corner.
Set iron pipe and marked BT's -
Tamarack 3" N85°E, 49 1/2 links
Black Spruce 2" N22°W, 62-3/4 links

Description of corner evidence found:

Recovered a 2 1/2" iron pipe with 4" squared brass cap, stamped:
Pipe projects 30" above ground.
Also recovered a badly rotted part of an old cedar post,
some scribing still legible.
Recovered OBT's -
Tamarack 3" (5") N85°E, 49.25 links, scribing grown over
Black Spruce 2" (5") N22°W, 62.75 links, scribed 1/4 BT

T38N R1E
1/4 S
S31 | S32
RIPCO

Description of monument and accessories I established to perpetuate the original location of this corner.

NBT's - Red Pine 6" N5°W, 100.5 links
scribed 1/4 BT
Black Spruce 6" S87°W, 120.3 links
scribed 1/4 BT

Dated at Rhinelander, Wis., this 18th day of May, 1978

Signature: Phillip T. Hansen Title Registered Land Surveyor Registration No. S-498
(County Surveyor, Registered Land Surveyor, or other duly authorized official)

Office of Register of Deeds, County of Oneida
instrument was filed in this office for record on the 22nd day of May, 1978
at 10⁰⁰ o'clock P. M.

Doree Terage Kuehn
(Register of Deeds)

By: _____ Deputy

3811312000